



RECEIVED
 AUG 7 2008
 YOLO COUNTY PARKS & RESOURCES
 DEPARTMENT

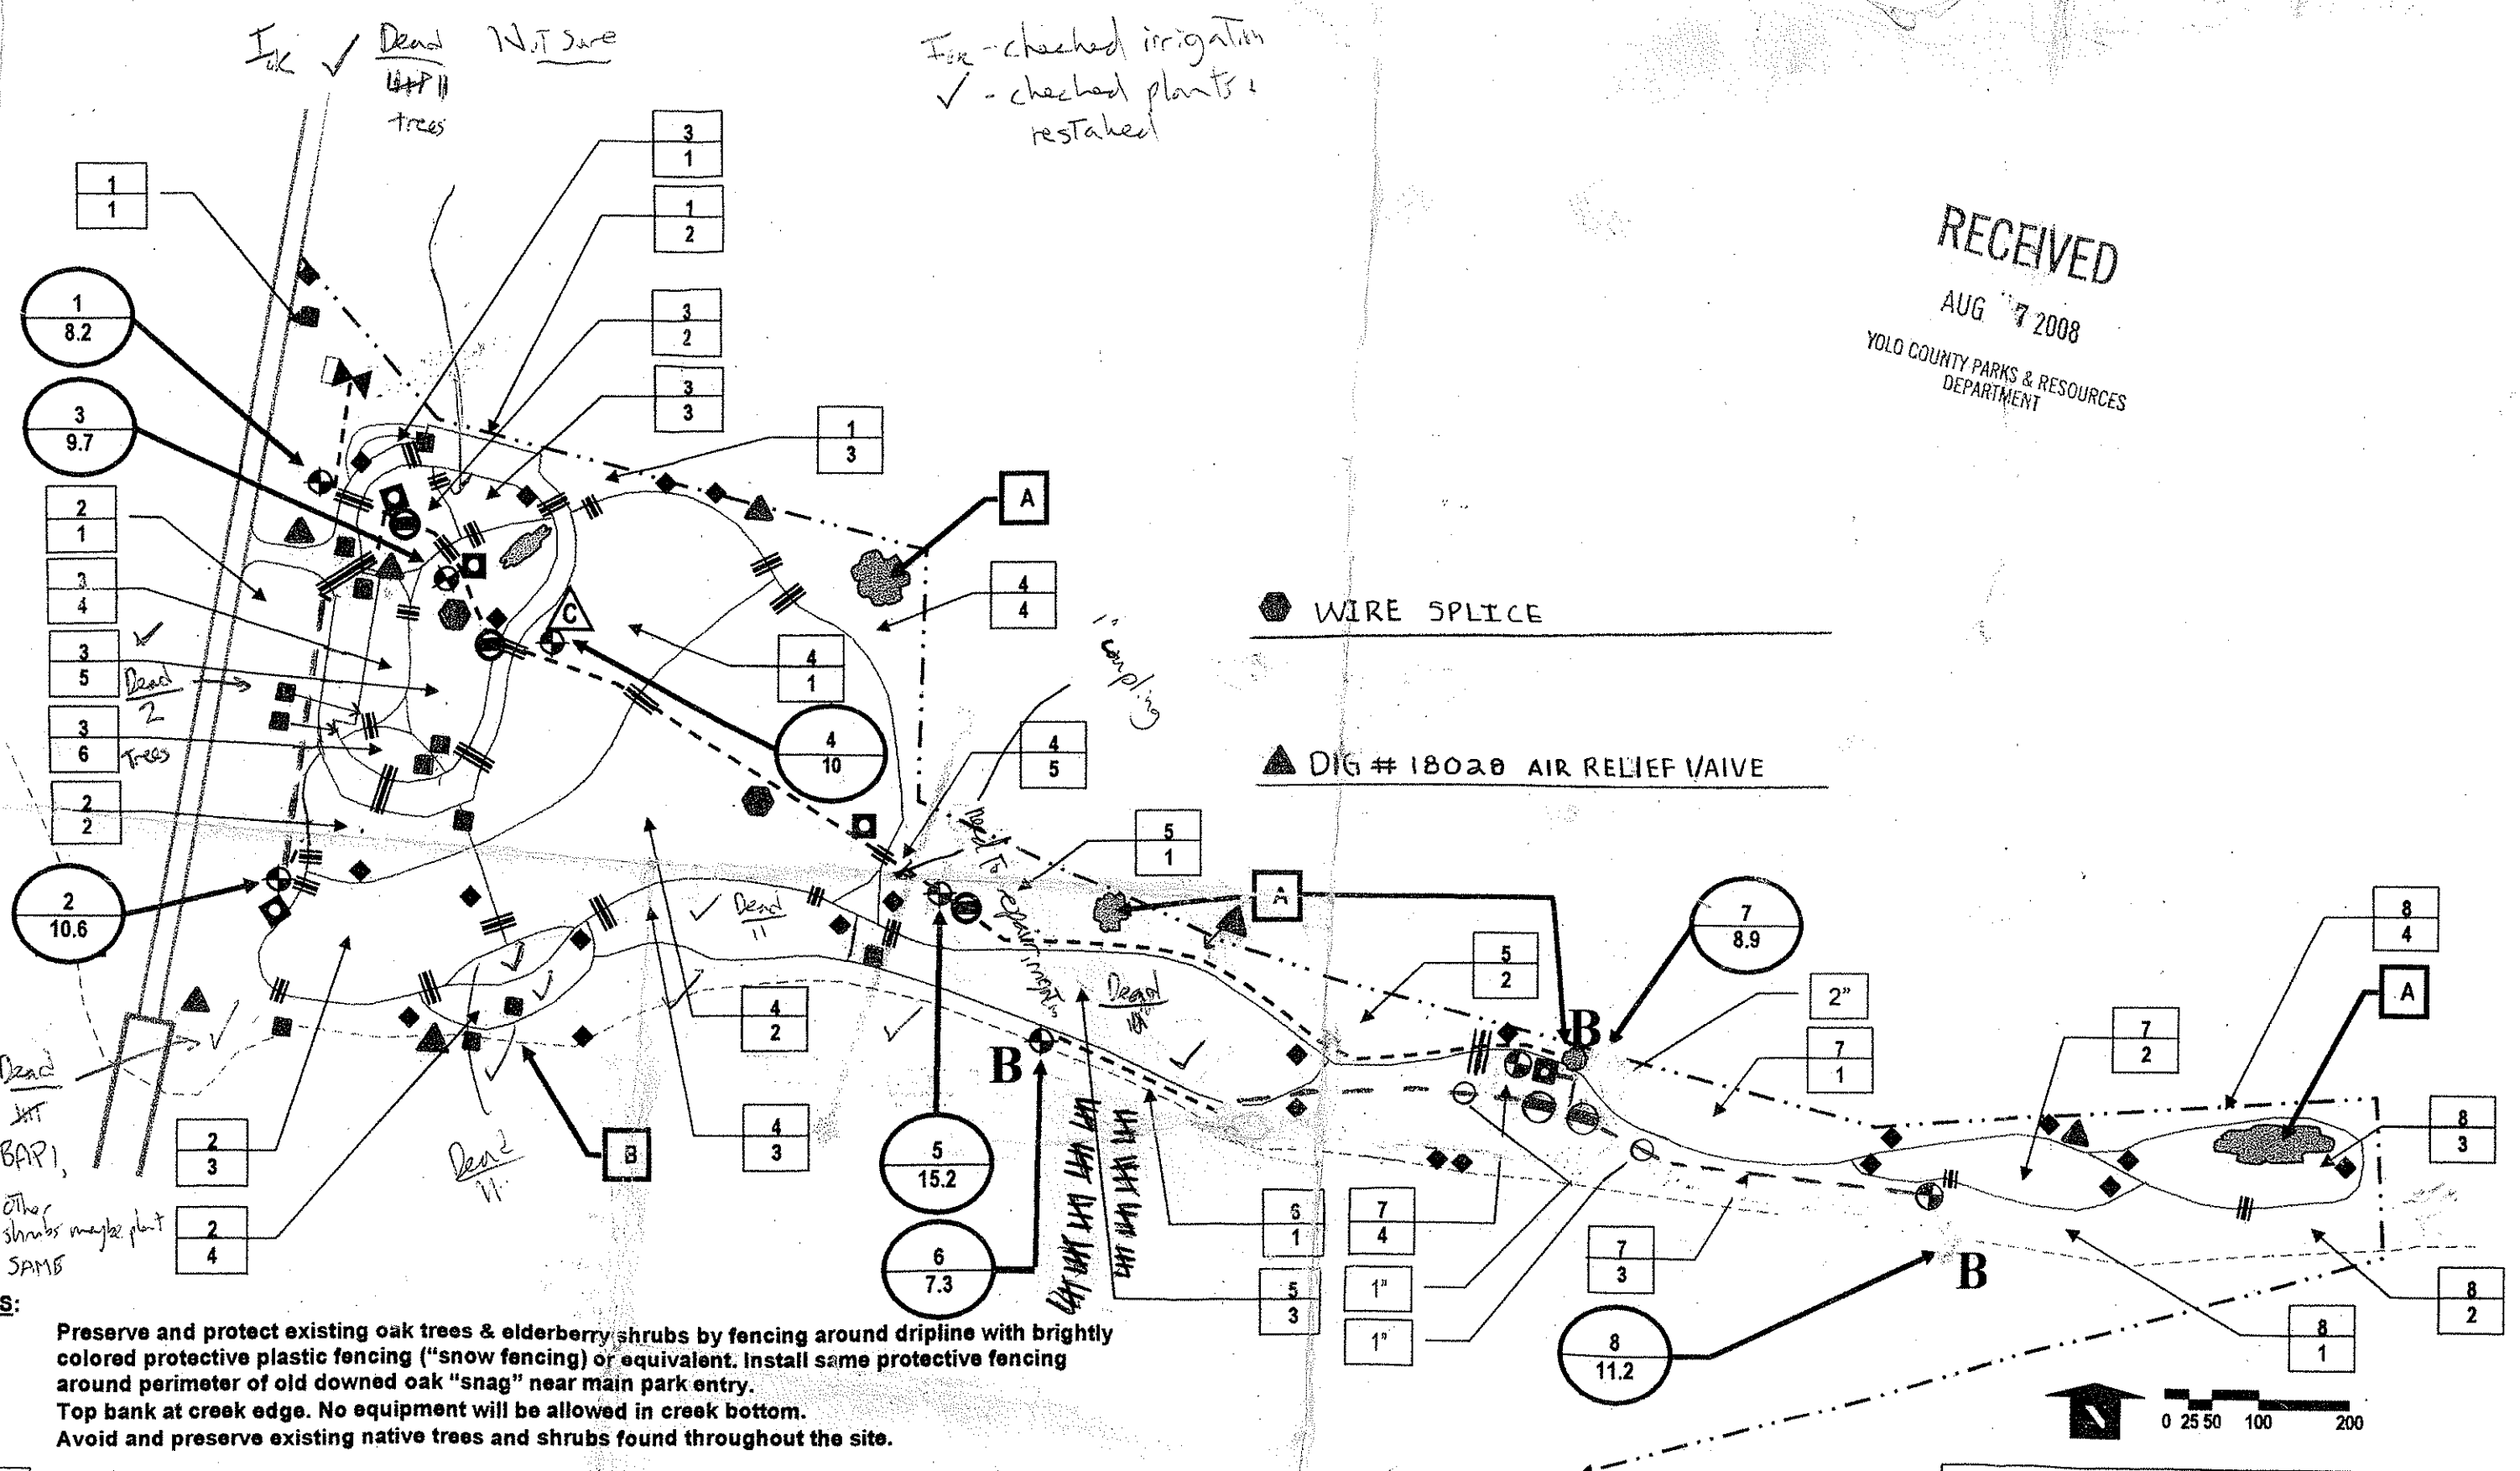

● WIRE SPLICE
 ▲ DIG # 18020 AIR RELIEF VAIVE

S:
 Preserve and protect existing oak trees & elderberry shrubs by fencing around dripline with brightly colored protective plastic fencing ("snow fencing) or equivalent. Install same protective fencing around perimeter of old downed oak "snag" near main park entry.
 Top bank at creek edge. No equipment will be allowed in creek bottom.
 Avoid and preserve existing native trees and shrubs found throughout the site.

← Valve number and the associated drip line that serves that sub-area.
 ← General reference sub-area associated with the valve.
 ← Valve #
 ← Approximate gallonage expected
 1" Pipe sizing designation (other than 2")

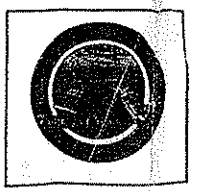

YOLO COUNTY
 PARKS & RESOURCES DEPARTMENT
CAPAY OPEN SPACE PARK

AS BUILT 7-x-08

IRRIGATION PLAN

DATE: 4-23-08 PAGE 1 OF 4 I-1