

BP # 990306

O.M.B. NO. 3067-0077
Expires May 31, 1996

ELEVATION CERTIFICATE

FEDERAL EMERGENCY MANAGEMENT AGENCY NATIONAL FLOOD INSURANCE PROGRAM

ATTENTION: Use of this certificate does not provide a waiver of the flood insurance purchase requirement. This form is used only to provide elevation information necessary to ensure compliance with applicable community floodplain management ordinances, to determine the proper insurance premium rate, and/or to support a request for a Letter of Map Amendment or Revision (LOMA or LOMR). Instructions for completing this form can be found on the following pages.

SECTION A PROPERTY INFORMATION		FOR INSURANCE COMPANY USE
BUILDING OWNER'S NAME <u>JAMES G JELKS</u>		POLICY NUMBER
STREET ADDRESS (Including Apt., Unit, Suite and/or Bldg. Number) OR P.O. ROUTE AND BOX NUMBER <u>11095 ST. HWY. 16</u>		COMPANY NAIC NUMBER
OTHER DESCRIPTION (Lot and Block Numbers, etc.) <u>060-090-10 1940' EAST OF HWY 16 ALONG PRIVATE ROAD</u>		
CITY <u>CAPAY</u> (NORTH OF TANKS) <u>YOLO COUNTY</u>	STATE <u>CA</u>	ZIP CODE <u>95606</u>

SECTION B FLOOD INSURANCE RATE MAP (FIRM) INFORMATION

Provide the following from the proper FIRM (See Instructions)

1. COMMUNITY NUMBER	2. PANEL NUMBER	3. SUFFIX	4. DATE OF FIRM INDEX	5. FIRM ZONE	6. BASE FLOOD ELEVATION (in AO Zones, use depth)
<u>060423</u>	<u>0225</u>	<u>B</u>	<u>DEC. 16, 1981</u>	<u>"A"</u>	<u>NOT SHOWN</u>

7. Indicate the elevation datum system used on the FIRM for Base Flood Elevations (BFE): NGVD '29 Other (describe on back)
8. For Zones A or V, where no BFE is provided on the FIRM, and the community has established a BFE for this building site, indicate the community's BFE: feet NGVD (or other FIRM datum—see Section B, Item 7).

SECTION C BUILDING ELEVATION INFORMATION

1. Using the Elevation Certificate Instructions, indicate the diagram number from the diagrams found on Pages 5 and 6 that best describes the subject building's reference level 1 (SEE COMMENTS)
- (a) FIRM Zones A1-A30, AE, AH, and A (with BFE). The top of the reference level floor from the selected diagram is at an elevation of feet NGVD (or other FIRM datum—see Section B, Item 7).
- (b) FIRM Zones V1-V30, VE, and V (with BFE). The bottom of the lowest horizontal structural member of the reference level from the selected diagram, is at an elevation of feet NGVD (or other FIRM datum—see Section B, Item 7).
- (c) FIRM Zone A (without BFE). The floor used as the reference level from the selected diagram is feet above or EL 308.8 (AS BUILT) below (check one) the highest grade adjacent to the building.
- (d) FIRM Zone AO. The floor used as the reference level from the selected diagram is feet above or below (check one) the highest grade adjacent to the building. If no flood depth number is available, is the building's lowest floor (reference level) elevated in accordance with the community's floodplain management ordinance? Yes No Unknown
3. Indicate the elevation datum system used in determining the above reference level elevations: NGVD '29 Other (describe under Comments on Page 2). (NOTE: If the elevation datum used in measuring the elevations is different than that used on the FIRM [see Section B, Item 7], then convert the elevations to the datum system used on the FIRM and show the conversion equation under Comments on Page 2.)
4. Elevation reference mark used appears on FIRM: Yes No (See Instructions on Page 4)
5. The reference level elevation is based on: actual construction construction drawings (NOTE: Use of construction drawings is only valid if the building does not yet have the reference level floor in place, in which case this certificate will only be valid for the building during the course of construction. A post-construction Elevation Certificate will be required once construction is complete.)
6. The elevation of the lowest grade immediately adjacent to the building is: 1130.618 feet NGVD (or other FIRM datum—see Section B, Item 7).

SECTION D COMMUNITY INFORMATION


1. If the community official responsible for verifying building elevations specifies that the reference level indicated in Section C, Item 1 is not the "lowest floor" as defined in the community's floodplain management ordinance, the elevation of the building's "lowest floor" as defined by the ordinance is: feet NGVD (or other FIRM datum—see Section B, Item 7).
2. Date of the start of construction or substantial improvement:

SECTION E CERTIFICATION

This certification is to be signed by a land surveyor, engineer, or architect who is authorized by state or local law to certify elevation information when the elevation information for Zones A1-A30, AE, AH, A (with BFE), 1-V30, VE, and V (with BFE) is required. Community officials who are authorized by local law or ordinance to provide floodplain management information, may also sign the certification. In the case of Zones AO and A (without a FEMA or community issued BFE), a building official, a property owner, or an owner's representative may also sign the certification.

Reference level diagrams 6, 7 and 8 - Distinguishing Features-If the certifier is unable to certify to breakaway/non-breakaway wall, enclosure size, location of servicing equipment, area use, wall openings, or unfinished area Feature(s), then list the Feature(s) not included in the certification under Comments below. The diagram number, Section C Item 1, must still be entered.

I certify that the information in Sections B and C on this certificate represents my best efforts to interpret the data available. I understand that any false statement may be punishable by fine or imprisonment under 18 U.S. Code, Section 1001.

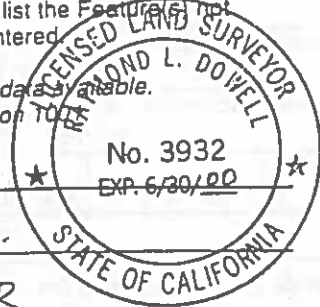

CERTIFIER'S NAME: RAYMOND L. DOWELL LICENSE NUMBER (or Affix Seal): L.S. 3932 CA


TITLE: OWNER COMPANY NAME: RAYMOND L. DOWELL-LAND SURVEYOR

ADDRESS: 17873 CO. RD. 9T CITY: WOODLAND STATE: CA ZIP: 95695


SIGNATURE: Raymond L. Dowell DATE: 4/23/99 PHONE: 530-662-0807

Copies should be made of this Certificate for: 1) community official, 2) insurance agent/company, and 3) building owner.

COMMENTS: (POLE BARN SITE) B.F.E. ESTIMATED BY INTERPOLATING BETWEEN THE USGS QUAD "GUINDA, CA." AND THE FLOOD PLANE LINE DEPICTED ON THE FIRM MAP, 060423-0225-B, DEC. 16, 1980. BY RUNNING GROUND ELEVATIONS FROM USGS MON GWM-26 (EL. 314.0) AT HWY 16, EAST ALONG THE GRAVELED ROAD TO THE SUBJECT SITE AND BY SCALING THE QUAD SHEET TO MY MEASUREMENTS, I SET THE GROUND ELEVATION AT THIS SITE TO BE EL 306.8 AND THE B.F.E. AT EL. 307.0

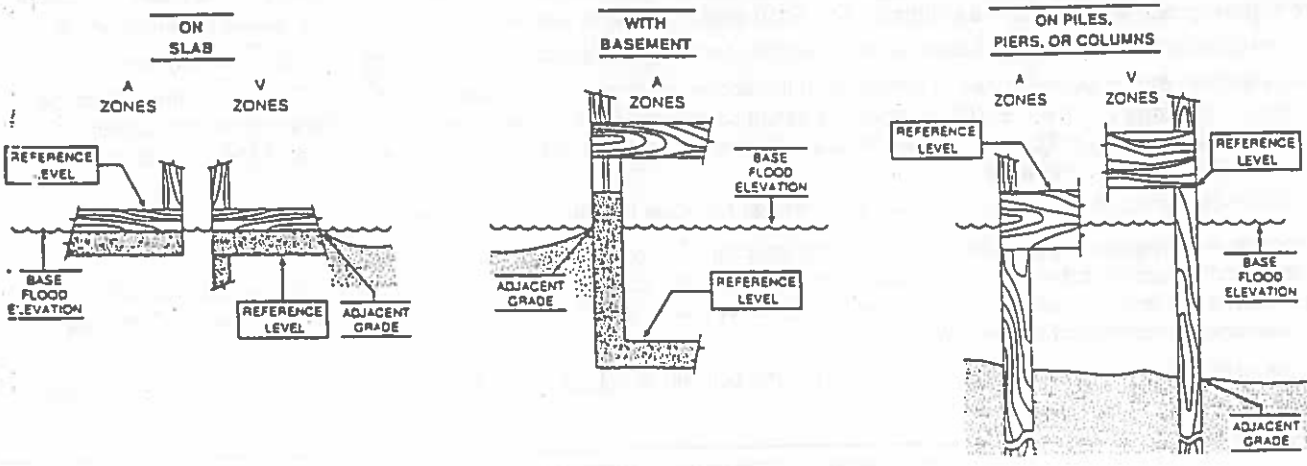

The diagrams above illustrate the points at which the elevations should be measured in A Zones and V Zones. Elevations for all A Zones should be measured at the top of the reference level. Elevations for all V Zones should be measured at the bottom of the lowest horizontal structural member.

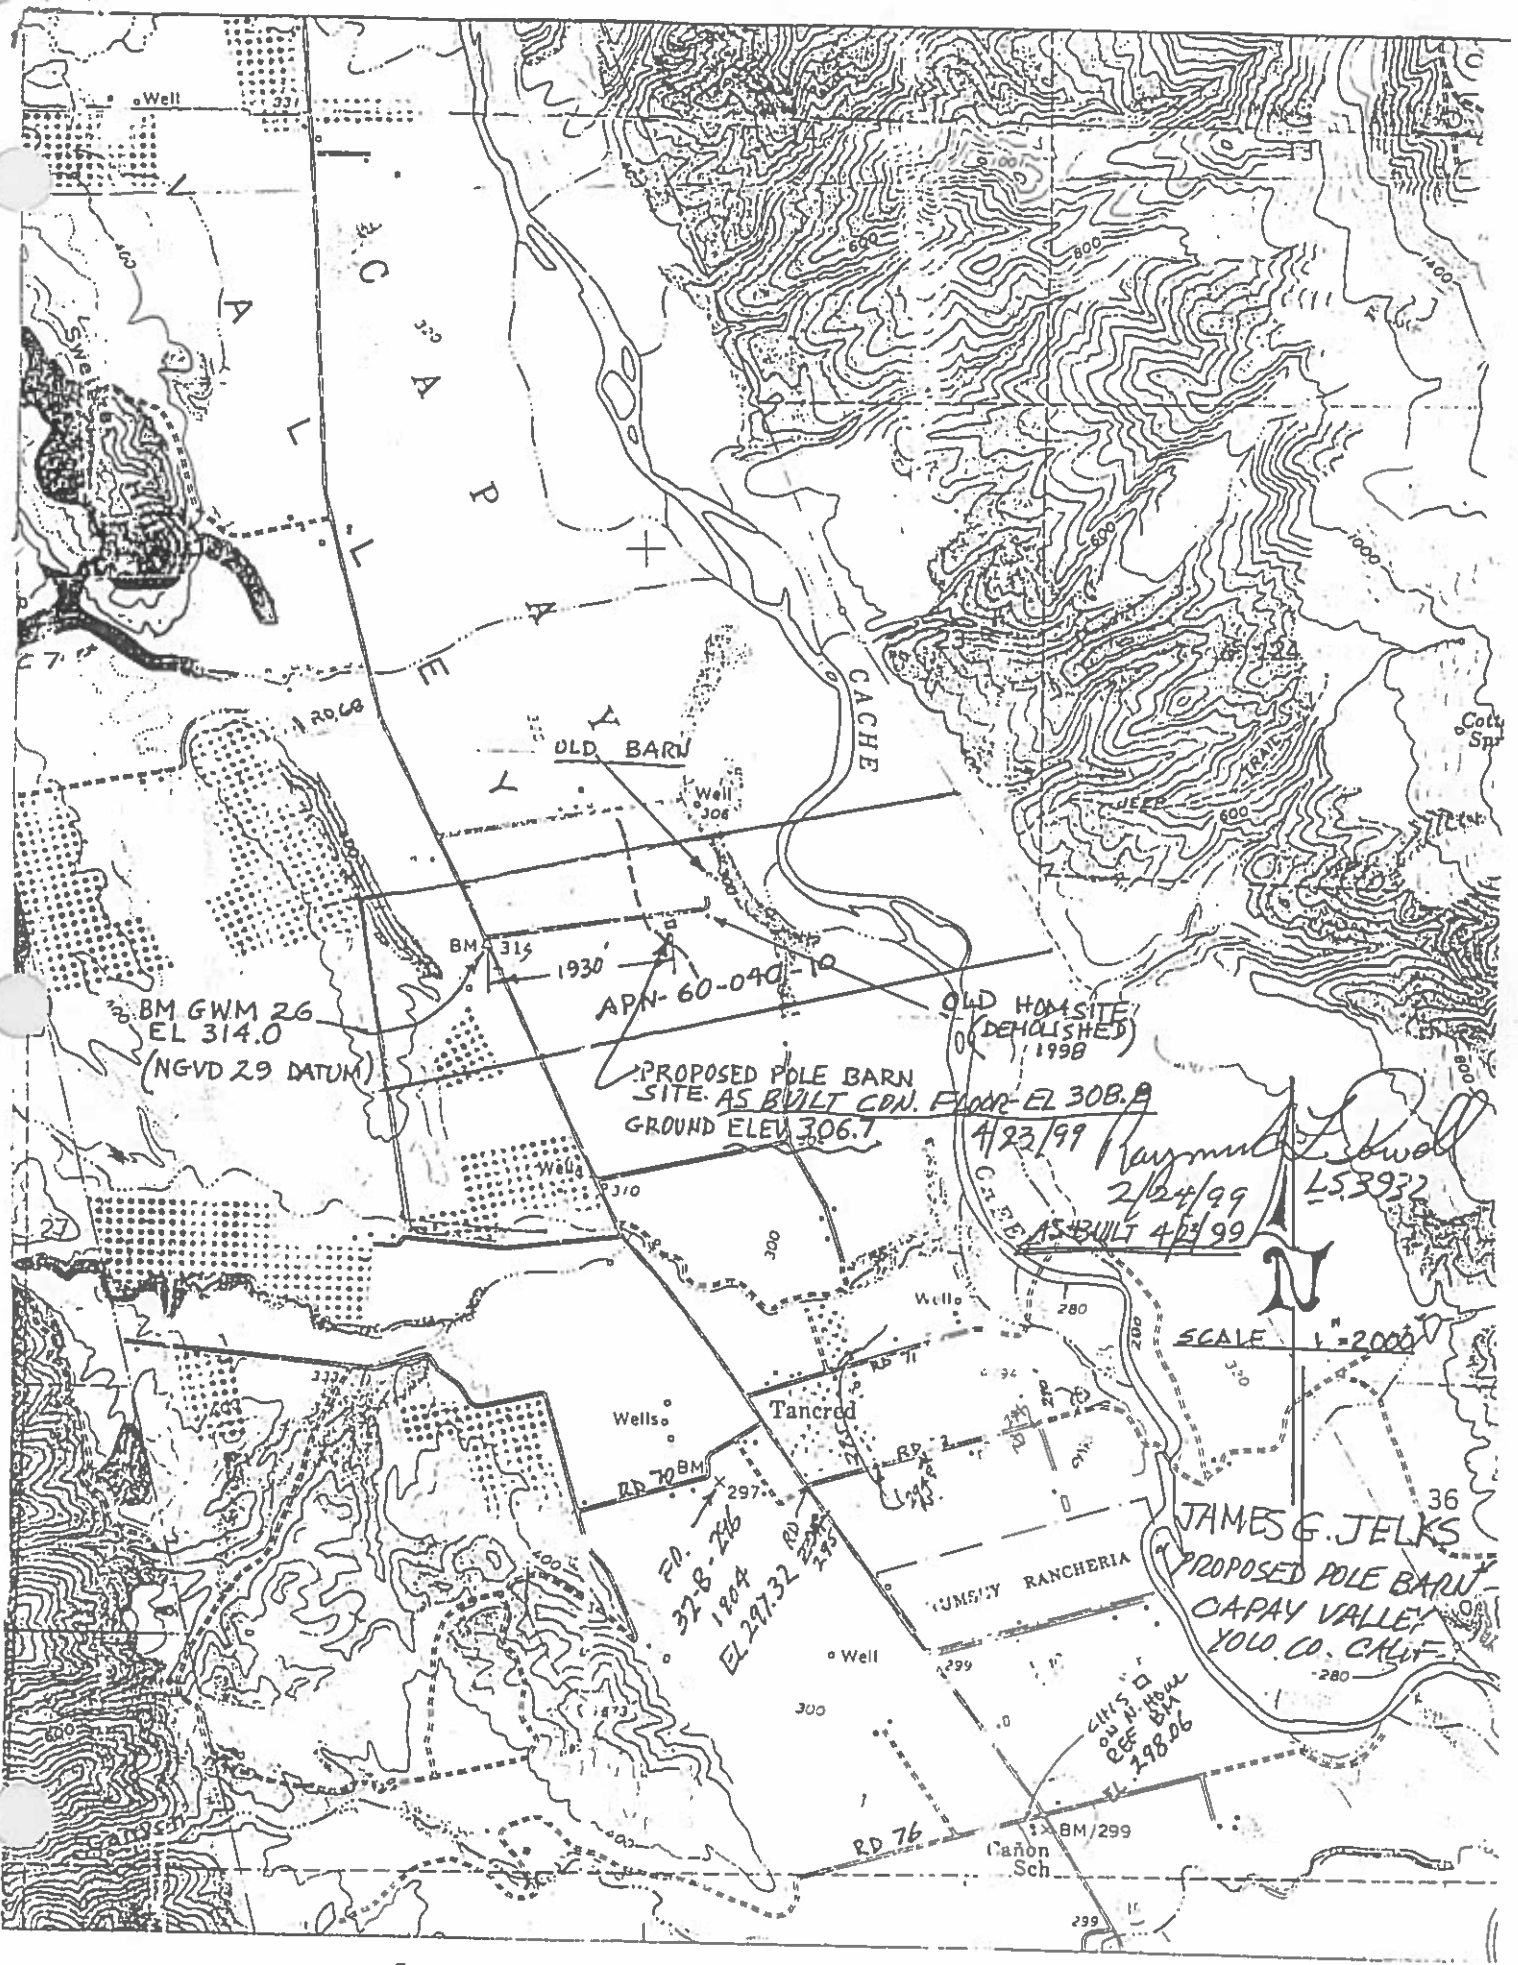

Well

CACHE

OLD BARN

CACHE

BM GWM 26
EL 314.0
(NGVD 29 DATUM)

APN-60-040-10

PROPOSED POLE BARN
SITE AS BUILT CON. FLOOR EL 308.9
GROUND ELEV 306.7

OLD HOME SITE
(DEMOLISHED)
1999

4/23/99 Raymond L. Lowell
2/24/99 L53932
AS BUILT 4/24/99

SCALE 1" = 2000'

Wells

Tancred

RD 70 BM

RD. 70B
328.206
1904
EL 297.32

JAMES G. JELKS
PROPOSED POLE BARN
CAPAY VALLEY
YOLO CO. CALIF.

Well


CHS D
000 N. 100 W
REF BPTM
EL 298.06

RD 76

BM/299
Canon Sch

299



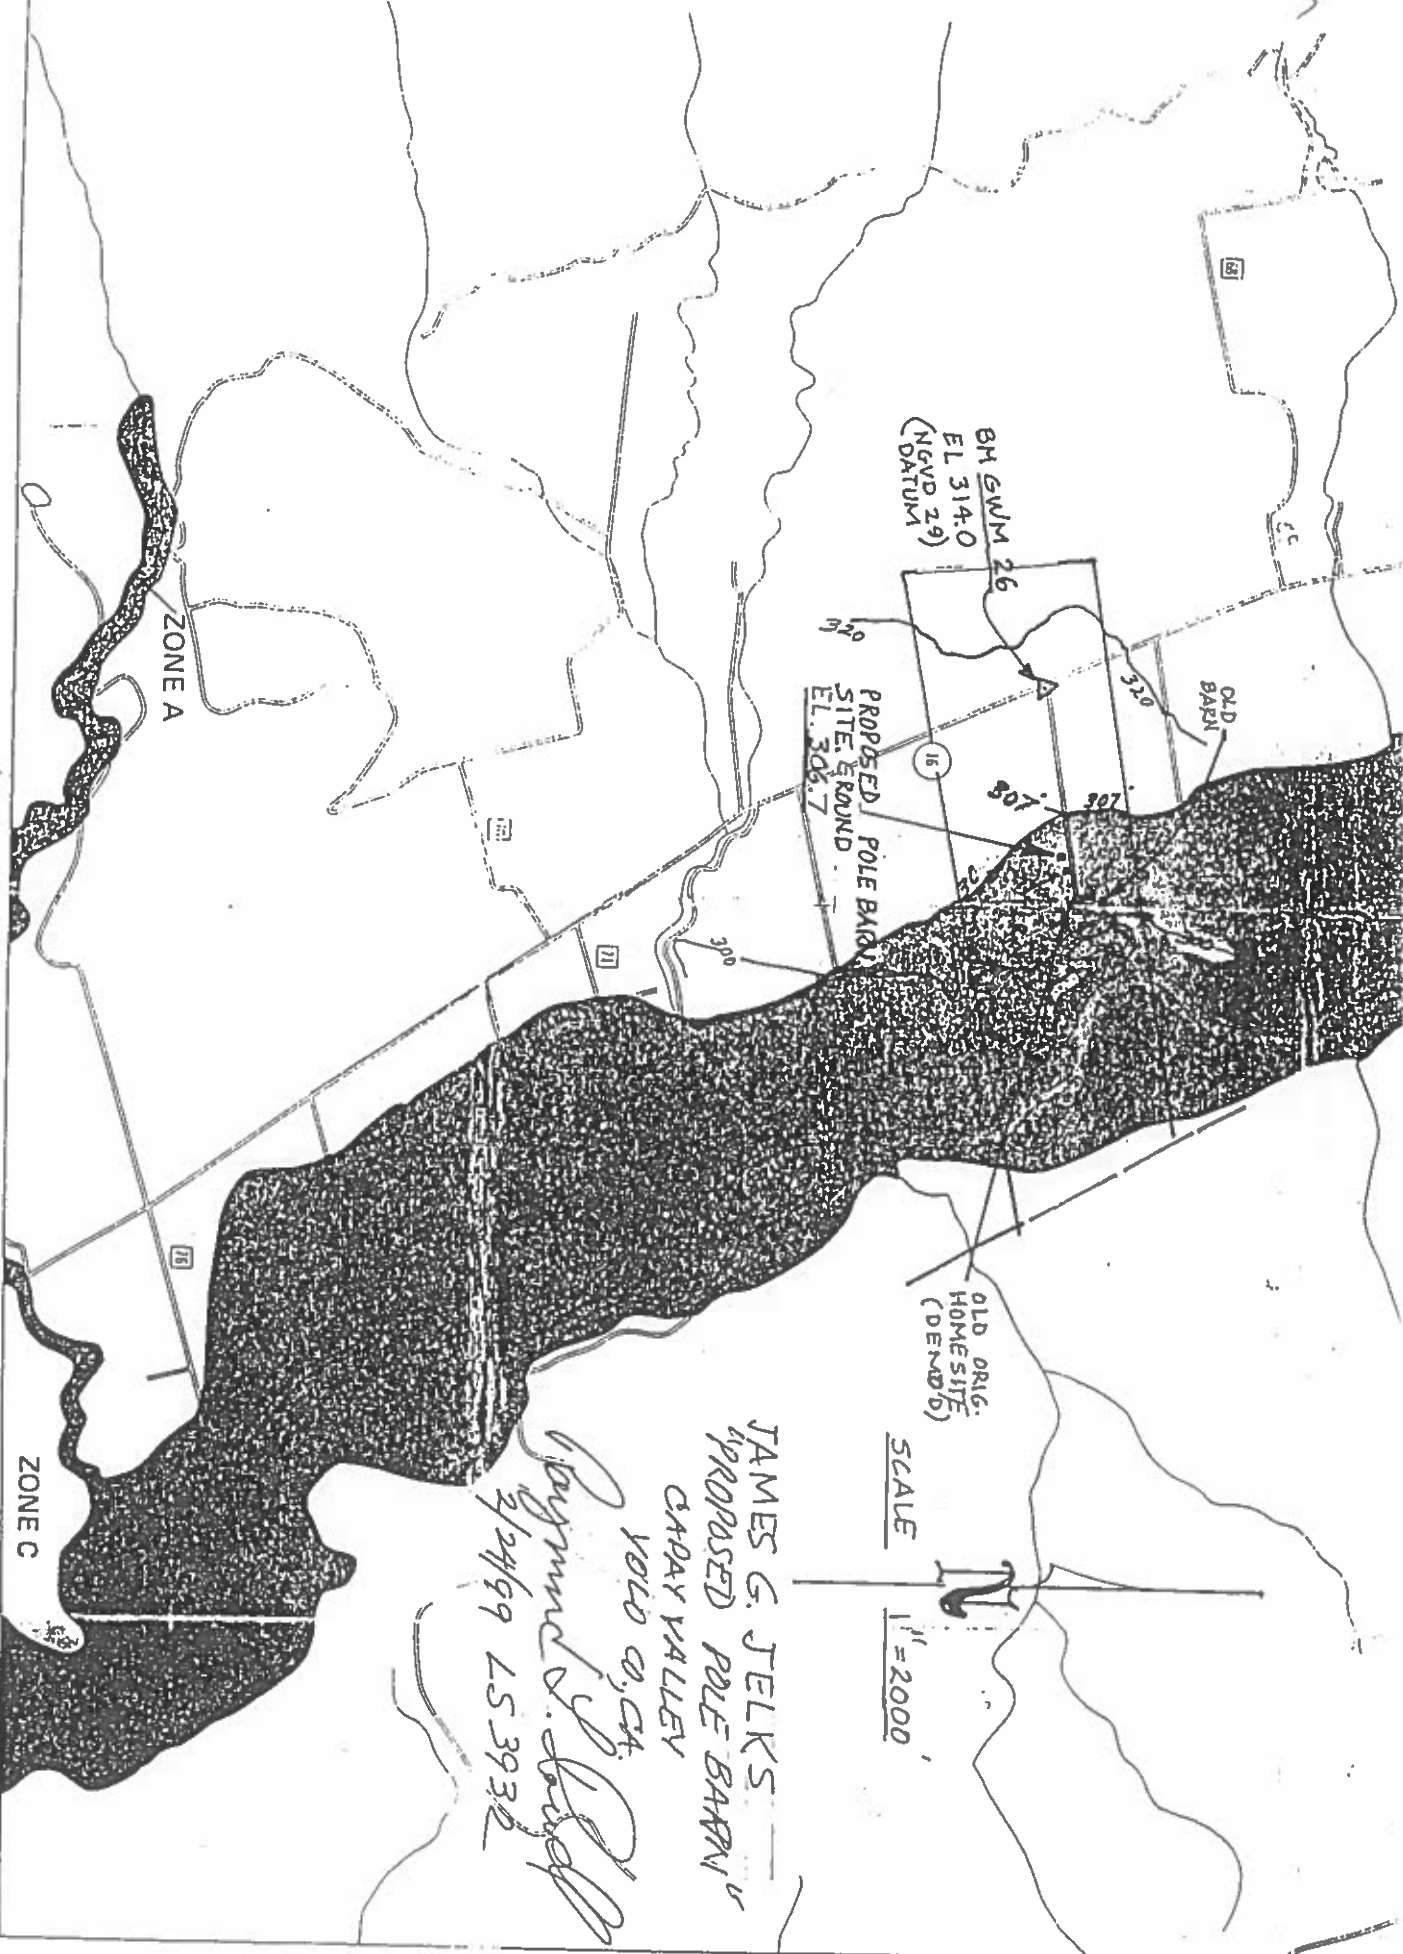

FIRM MAP
 060423-0225-R
 20

JAMES G. JELKS
 PROPOSED POLE BARN
 GARDY VALLEY
 YOLO CO., CA.
Raymond S. [Signature]
 3/24/99 LS 3932

Co. Rd. 57 / St. 16
Gwendolyn Bridge
Caltrans
Bridge #
Jurisdiction.

Road is dropping into
Creek
Redwood
North
1/4 mile

Call: 736-3750
Don Thompson