

BP 200-0673
FON 060-220-22

OK BR
10/22/01

FEDERAL EMERGENCY MANAGEMENT AGENCY
NATIONAL FLOOD INSURANCE PROGRAM

O.M.B. No. 3067-0077
Expires July 31, 2002

ELEVATION CERTIFICATE

Important: Read the instructions on pages 1 - 7.

SECTION A - PROPERTY OWNER INFORMATION		For Insurance Company Use:	
BUILDING OWNER'S NAME HOWARD F. JANES		Policy Number	
BUILDING STREET ADDRESS (Including Apt., Unit, Suite, and/or Bldg. No.) OR P.O. ROUTE AND BOX NO. 3833 HWY 16		Company NAIC Number	
CITY RUMSEY	STATE CA	ZIP CODE 95679	
PROPERTY DESCRIPTION (Lot and Block Numbers, Tax Parcel Number, Legal Description, etc.) A.P.N. 60-220-22			
BUILDING USE (e.g., Residential, Non-residential, Addition, Accessory, etc. Use Comments section if necessary.) RESIDENTIAL			
LATITUDE/LONGITUDE (OPTIONAL) (##° - ##' - ###.###" or ##.#####)		HORIZONTAL DATUM: SOURCE: <input type="checkbox"/> GPS (Type): <input checked="" type="checkbox"/> USGS Quad Map <input type="checkbox"/> Other: USGS-BM 418-B	

SECTION B - FLOOD INSURANCE RATE MAP (FIRM) INFORMATION

B1. NFIP COMMUNITY NAME & COMMUNITY NUMBER		B2. COUNTY NAME YOLO		B3. STATE CA	
B4. MAP AND PANEL NUMBER 060423-0075	B5. SUFFIX B	B6. FIRM INDEX DATE DEC 16, 1980	B7. FIRM PANEL EFFECTIVE/REVISED DATE	B8. FLOOD ZONE(S) A	B9. BASE FLOOD ELEVATION(S) (Zone AO, use depth of flooding) 413.6 ±

B10. Indicate the source of the Base Flood Elevation (BFE) data or base flood depth entered in B9.
 FIS Profile FIRM Community Determined Other (Describe): FIELD SURVEY-TIE TO USGS QUAD

B11. Indicate the elevation datum used for the BFE in B9: NGVD 1929 NAVD 1988 Other (Describe):

B12. Is the building located in a Coastal Barrier Resources System (CBRS) area or Otherwise Protected Area (OPA)? Yes No
Designation Date: _____


SECTION C - BUILDING ELEVATION INFORMATION (SURVEY REQUIRED)

C1. Building elevations are based on: Construction Drawings* Building Under Construction* Finished Construction
*A new Elevation Certificate will be required when construction of the building is complete.

C2. Building Diagram Number 8 (Select the building diagram most similar to the building for which this certificate is being completed - see pages 6 and 7. If no diagram accurately represents the building, provide a sketch or photograph.)

C3. Elevations - Zones A1-A30, AE, AH, A (with BFE), VE, V1-V30, V (with BFE), AR, AR/A, AR/AE, AR/A1-A30, AR/AH, AR/AO
Complete Items C3a-i below according to the building diagram specified in Item C2. State the datum used. If the datum is different from the datum used for the BFE in Section B, convert the datum to that used for the BFE. Show field measurements and datum conversion calculation. Use the space provided or the Comments area of Section D or Section G, as appropriate, to document the datum conversion.
Datum NGVD 1929 Conversion/Comments _____
Elevation reference mark used USGS BM 418-B Does the elevation reference mark used appear on the FIRM? Yes No

<input type="checkbox"/> a) Top of bottom floor (including basement or enclosure)	_____	414.6	ft.(m)
<input type="checkbox"/> b) Top of next higher floor	_____	_____	ft.(m)
<input type="checkbox"/> c) Bottom of lowest horizontal structural member (V zones only)	_____	_____	ft.(m)
<input type="checkbox"/> d) Attached garage (top of slab)	_____	_____	ft.(m)
<input type="checkbox"/> e) Lowest elevation of machinery and/or equipment servicing the building	_____	414.9	ft.(m)
<input type="checkbox"/> f) Lowest adjacent grade (LAG)	_____	409.6	ft.(m)
<input type="checkbox"/> g) Highest adjacent grade (HAG)	_____	411.0	ft.(m)
<input type="checkbox"/> h) No. of permanent openings (flood vents) within 1 ft. above adjacent grade	_____	_____	
<input type="checkbox"/> i) Total area of all permanent openings (flood vents) in C3h	2061	sq. in.	(sq. cm)

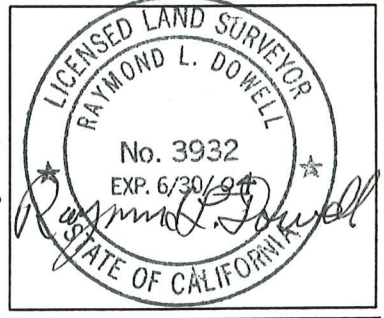

SECTION D - SURVEYOR, ENGINEER, OR ARCHITECT CERTIFICATION

This certification is to be signed and sealed by a land surveyor, engineer, or architect authorized by law to certify elevation information.
I certify that the information in Sections A, B, and C on this certificate represents my best efforts to interpret the data available.
I understand that any false statement may be punishable by fine or imprisonment under 18 U.S. Code, Section 1001.

CERTIFIER'S NAME: RAYMOND L. DOWELL LICENSE NUMBER: L.S. 3932

TITLE: OWNER COMPANY NAME: RAYMOND L. DOWELL - LAND SURVEYOR

ADDRESS: 17873 CO. RD. 97 CITY: WOODLAND STATE: CA ZIP CODE: 95695

SIGNATURE: Raymond L. Dowell DATE: 10/4/01 TELEPHONE: 530-662-0807

IMPORTANT: In these spaces, copy the corresponding information from Section A.			For Insurance Company Use:
BUILDING STREET ADDRESS (Including Apt., Unit, Suite, and/or Bldg. No.) OR P.O. ROUTE AND BOX NO. 3833 HWY 16			Policy Number
CITY RUMSEY	STATE CA.	ZIP CODE 95679	Company NAIC Number

SECTION D - SURVEYOR, ENGINEER, OR ARCHITECT CERTIFICATION (CONTINUED)

Copy both sides of this Elevation Certificate for (1) community official, (2) insurance agent/company, and (3) building owner.

COMMENTS

Check here if attachments

SECTION E - BUILDING ELEVATION INFORMATION (SURVEY NOT REQUIRED) FOR ZONE AO and ZONE A (WITHOUT BFE)

For Zone AO and Zone A (without BFE), complete Items E1 through E3. If the Elevation Certificate is intended for use as supporting information for a LOMA or LOMR-F, Section C must be completed.

- E1. Building Diagram Number 8 (Select the building diagram most similar to the building for which this certificate is being completed – see pages 6 and 7. If no diagram accurately represents the building, provide a sketch or photograph.)
- E2. The top of the bottom floor (including basement or enclosure) of the building is 3 ft.(m) 7 in.(cm) above or below (check one) the highest adjacent grade.
- E3. For Zone AO only: If no flood depth number is available, is the top of the bottom floor elevated in accordance with the community's floodplain management ordinance? Yes No Unknown. The local official must certify this information in Section G.

SECTION F - PROPERTY OWNER (OR OWNER'S REPRESENTATIVE) CERTIFICATION

The property owner or owner's authorized representative who completes Sections A, B, and E for Zone A (without a FEMA-issued or community-issued BFE) or Zone AO must sign here.

RAYMOND L. DOWELL, L.S. 3932
PROPERTY OWNER'S OR OWNER'S AUTHORIZED REPRESENTATIVE'S NAME

ADDRESS 17873 CO. RD. 97	CITY WOODLAND	STATE CA	ZIP CODE 95695
SIGNATURE <i>Raymond L. Dowell</i>	DATE 10/4/01	TELEPHONE 530-662-0807	
COMMENTS SEE EXHIBITS "A" & B			

Check here if attachments

SECTION G - COMMUNITY INFORMATION (OPTIONAL)

The local official who is authorized by law or ordinance to administer the community's floodplain management ordinance can complete Sections A, B, C (or E), and G of this Elevation Certificate. Complete the applicable item(s) and sign below.

- G1. The information in Section C was taken from other documentation that has been signed and embossed by a licensed surveyor, engineer, or architect who is authorized by state or local law to certify elevation information. (Indicate the source and date of the elevation data in the Comments area below.)
- G2. A community official completed Section E for a building located in Zone A (without a FEMA-issued or community-issued BFE) or Zone AO.
- G3. The following information (Items G4-G9) is provided for community floodplain management purposes.

G4. PERMIT NUMBER	G5. DATE PERMIT ISSUED	G6. DATE CERTIFICATE OF COMPLIANCE/OCCUPANCY ISSUED
-------------------	------------------------	---

- G7. This permit has been issued for: New Construction Substantial Improvement
- G8. Elevation of as-built lowest floor (including basement) of the building is: _____ ft.(m) Datum: _____
- G9. BFE or (in Zone AO) depth of flooding at the building site is: _____ ft.(m) Datum: _____

LOCAL OFFICIAL'S NAME	TITLE
COMMUNITY NAME	TELEPHONE
SIGNATURE	DATE
COMMENTS	

Check here if attachments

August Janes & Hattie M. Janes

Parcel No. 4

Parcel No. 5

Parcel No. 6

chard

R/W 100' wide.

Prune and nond Orchard

S. 25° 36' E
382.12

S. 25° 36' E

HWY 16

Hattie M. Janes

August Janes & Hattie M. Janes

August Janes & Hattie M. Janes

Irrigation Ditch

Plums

Way


Traveled (1944)

EXHIBIT "A"
EXISTING
HOMESITE
B.F.E. EL. 43.6

BM. ON
CON.
DOMESTIC
WELL BASE
EL. 410.3

Top of Bank (1944)

Cache Creek

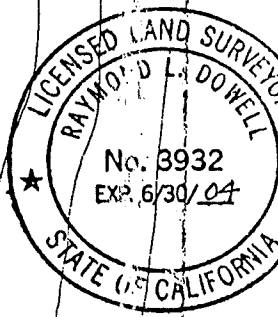


HOWARD F. JANES
PROPOSED HOMESITE


APN. 60-220-22

"RUMSEY", YOLO COUNTY
(ELEV. DATUM - USGS 418-B)
(AT RUMSEY EL. 419.24)

Raymond L. Dowell 153932
10/4/01

SCALE
1" = 100'
(COPY - CALTRANS)
HWY - 16
1944

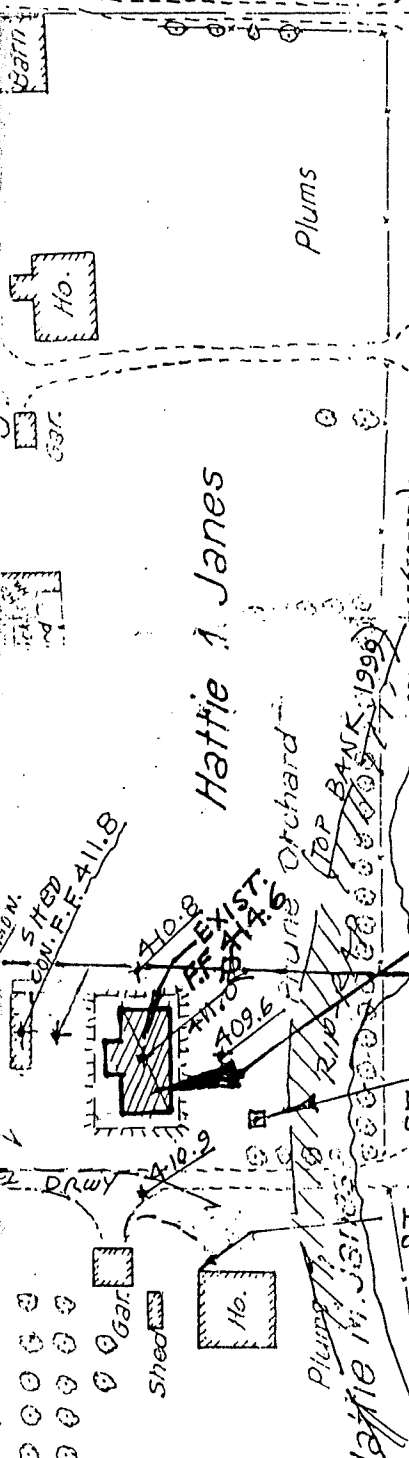

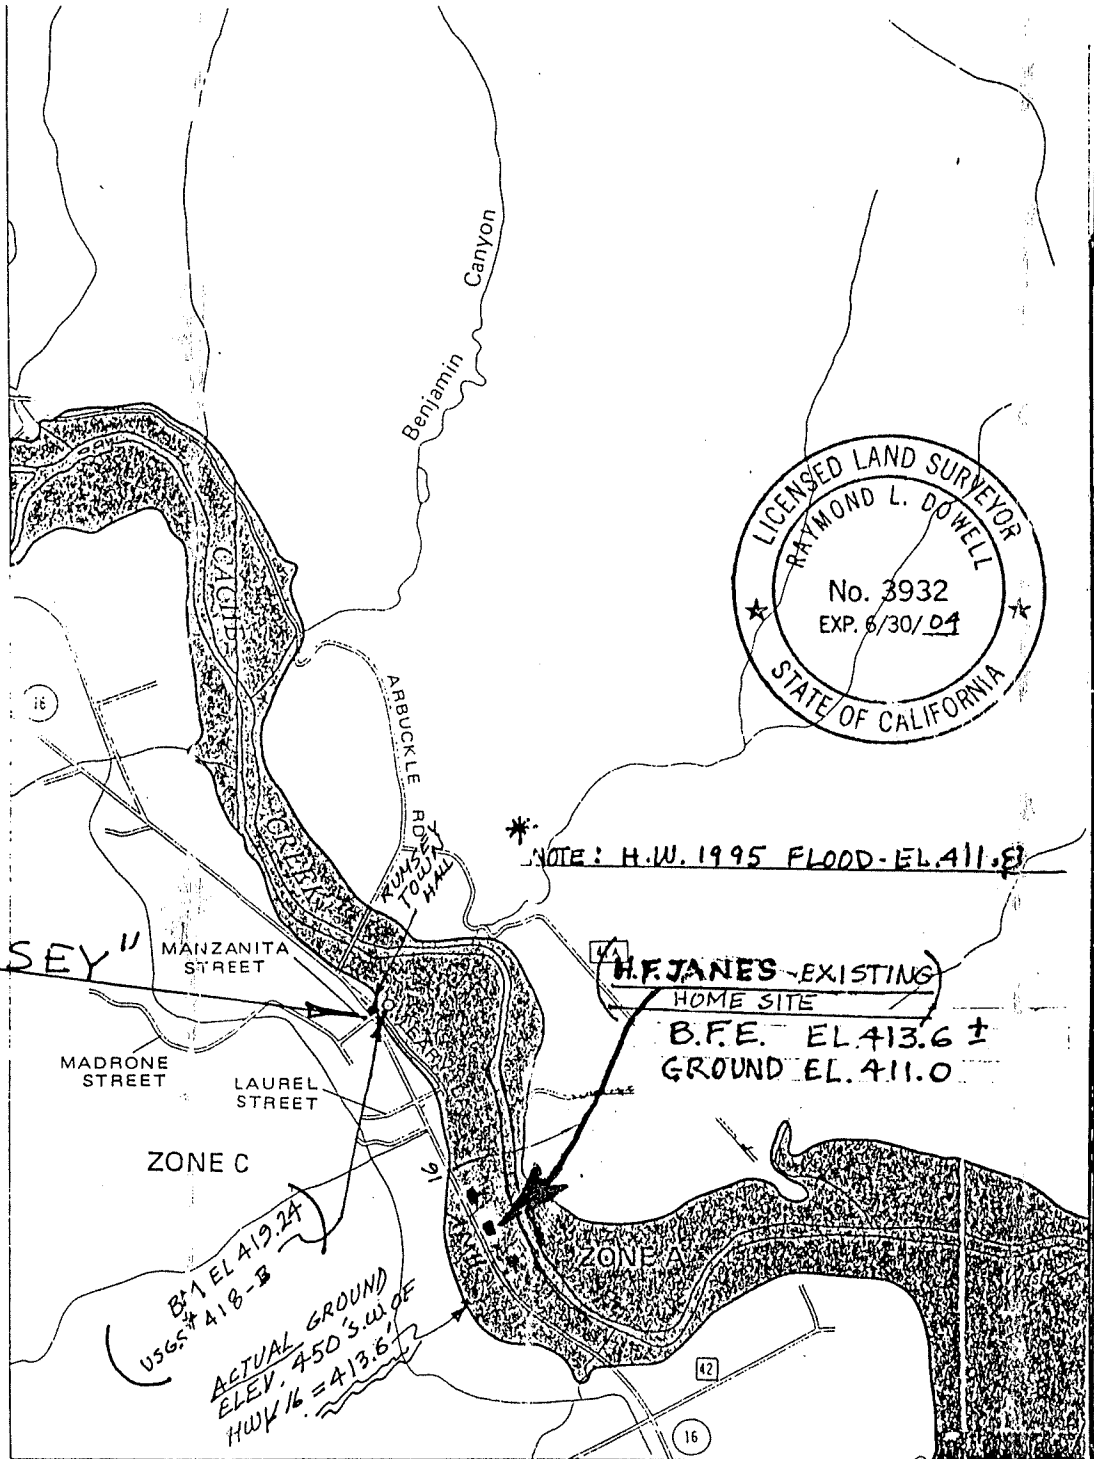

NOTE: H.W. 1995 FLOOD - EL. 411.0

H.F. JAMES - EXISTING HOME SITE
 B.F.E. EL. 413.6 ±
 GROUND EL. 411.0

B.M. EL. 419.24
 USGS # 418-B
 ACTUAL GROUND
 ELEV. 450 S.W. OF
 HWY 16 = 413.6

SCALE 1" = 2000'

FEMA MAP 060423 - 0075 - B EXHIBIT "3"
 HOWARD JAMES PROPOSED HOMESITE
 Raymond L. Dowell - LS 3932
 10/4/04