


SECTION E CERTIFICATION

This certification is to be signed by a land surveyor, engineer, or architect who is authorized by state or local law to certify elevation information when the elevation information for Zones A1-A30, AE, AH, A (with BFE), V1-V30, VE, and V (with BFE) is required. Community officials who are authorized by local law or ordinance to provide floodplain management information, may also sign the certification. In the case of Zones AO and A (without a FEMA or community issued BFE), a building official, a property owner, or an owner's representative may also sign the certification.

Reference level diagrams 6, 7 and 8 - Distinguishing Features-If the certifier is unable to certify to breakaway/non-breakaway wall, enclosure size, location of servicing equipment, area use, wall openings, or unfinished area Feature(s), then list the Feature(s) not included in the certification under Comments below. The diagram number, Section C, Item 1, must still be entered.


I certify that the information in Sections B and C on this certificate represents my best efforts to interpret the data available.
I understand that any false statement may be punishable by fine or imprisonment under 18 U.S. Code, Section 1001.

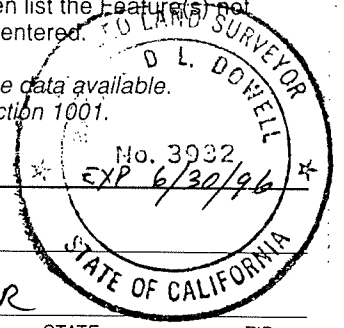


CERTIFIER'S NAME RAYMOND L. DOWELL		LICENSE NUMBER (or Affix Seal) L.S. 3932	
TITLE OWNER	COMPANY NAME RAYMOND L. DOWELL - LAND SURVEYOR		
ADDRESS 17873 CO. RD. 97	CITY WOODLAND	STATE CA.	ZIP 95695
SIGNATURE <i>Raymond L. Dowell</i>	DATE FEB. 6 1996	PHONE 916-662-0807	

Copies should be made of this Certificate for: 1) community official, 2) insurance agent/company, and 3) building owner.

COMMENTS: _____

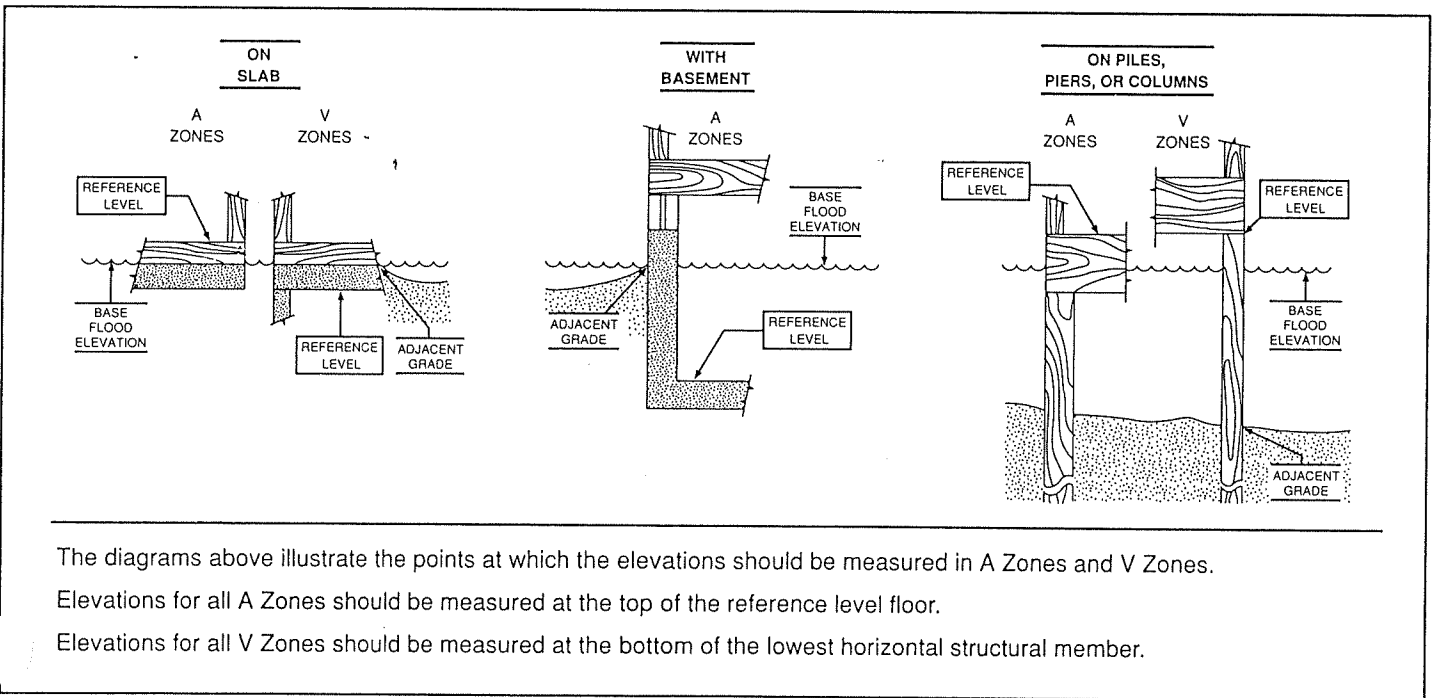


RAYMOND L. DOWELL
17273 C. Rd. 97

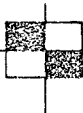

LAND SURVEYOR
WOODLAND CA 95695

PHONE 662-0807

JOB: GORDON RASMUSSEN
PROPOSED HOUSE TRAILER SITE
S.W. 1/4, SECT. 31, T. 7N., R. 3E. MDM, YOLO CO., CA
CHECKED BY: [AS BUILT] DATE: 8/25/95
SCALE: 1" = 200' CALC BY: RLD SH. 1 OF 1 RLD

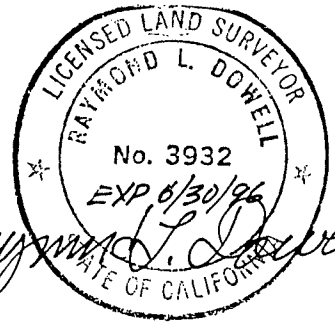


Raymond L. Dowell



ELEV. DATUM: U.S.G.S. (NGVD-1929)

NOTE: (REVISION 2 FEB. 6, 1996)
AS BUILT ELEVATIONS
IN BRACKETS []

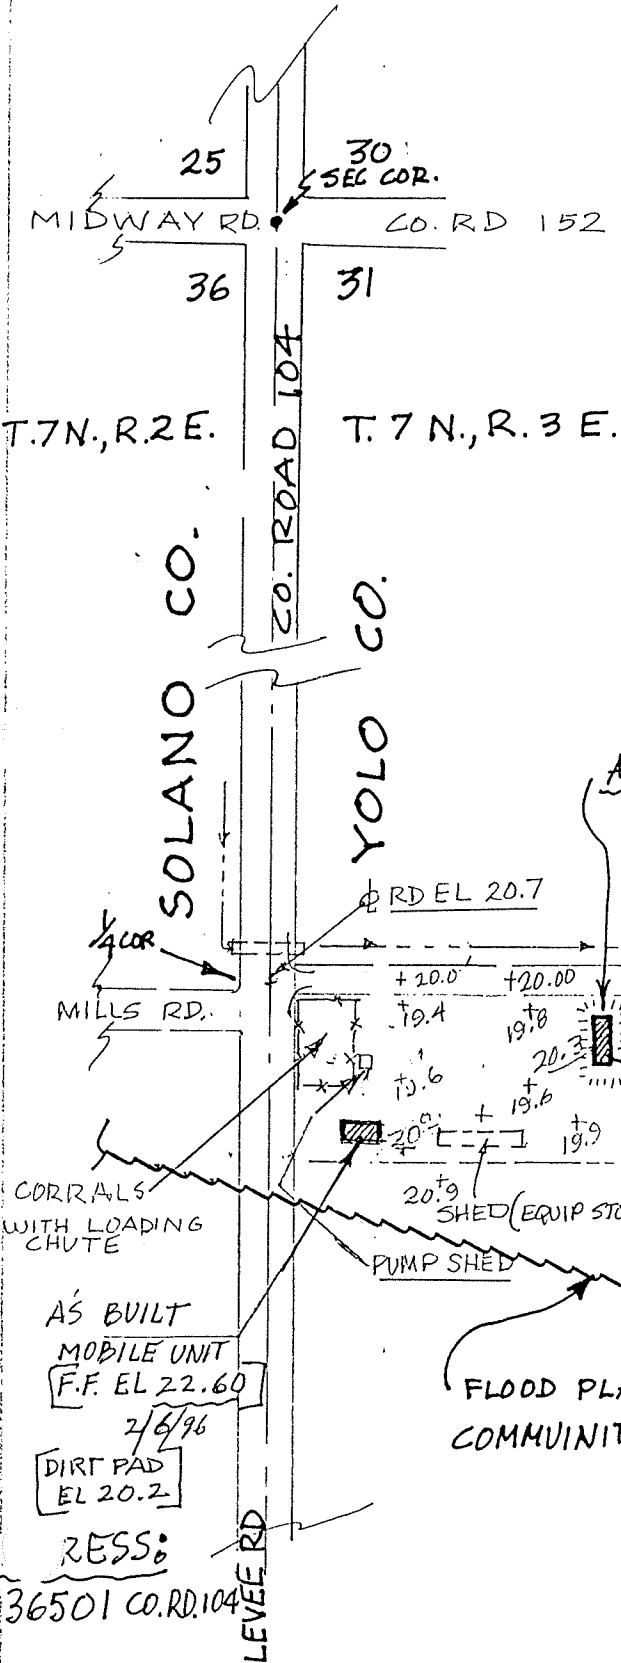

RASMUSSEN
A.P. NO 33-190-15

ADDRESS:
36505 CO. RD. 104

PROPOSED HOUSE TRAILER SITE
MIN. F.F. ELEV. 21.1
[AS BUILT F.F. ELEV. 25.2] 2/6/96
[TOP DIRT BUILDING PAD 22.7]

FLOOD PLANE ELEV. PER
COMMUNITY PANEL NO. 060423 0640 C
MAY 17, 1988

AS BUILT
MOBILE UNIT
F.F. EL 22.60
2/6/96
DIRT PAD
EL 20.2

ADDRESS:
36501 CO. RD. 104