

BA# 202-0713
OK - BA 6/12/02

5

FEDERAL EMERGENCY MANAGEMENT AGENCY
NATIONAL FLOOD INSURANCE PROGRAM

O.M.B. No. 3067-0077
Expires July 31, 2002

ELEVATION CERTIFICATE

Important: Read the instructions on pages 1 - 7.

SECTION A - PROPERTY OWNER INFORMATION		For Insurance Company Use:
BUILDING OWNER'S NAME RALPH ALDREDGE		Policy Number
BUILDING STREET ADDRESS (Including Apt., Unit, Suite, and/or Bldg. No.) OR P.O. ROUTE AND BOX NO. 35956 ACADIA LN.		Company NAIC Number
CITY DAVIS	STATE CA	ZIP CODE 95616
PROPERTY DESCRIPTION (Lot and Block Numbers, Tax Parcel Number, Legal Description, etc.) APN 40-190-53 LOT 64, BERRYVALE GARDENS, SUBD.		
BUILDING USE (e.g., Residential, Non-residential, Addition, Accessory, etc. Use Comments section if necessary.)		
LATITUDE/LONGITUDE (OPTIONAL) (##° - ##' - ###" or ##.#####°)	HORIZONTAL DATUM: <input type="checkbox"/> NAD 1927 <input type="checkbox"/> NAD 1983	SOURCE: <input type="checkbox"/> GPS (Type): _____ <input checked="" type="checkbox"/> USGS Quad Map <input type="checkbox"/> Other: _____

SECTION B - FLOOD INSURANCE RATE MAP (FIRM) INFORMATION

B1. NFIP COMMUNITY NAME & COMMUNITY NUMBER	B2. COUNTY NAME YOLO CO.	B3. STATE CA.
B4. MAP AND PANEL NUMBER 060423-0555	B5. SUFFIX C	B6. FIRM INDEX DATE MAR. 3, 1999
B7. FIRM PANEL EFFECTIVE/REVISED DATE	B8. FLOOD ZONE(S) A-1	B9. BASE FLOOD ELEVATION(S) (Zone AO, use depth of flooding) 80.0

B10. Indicate the source of the Base Flood Elevation (BFE) data or base flood depth entered in B9.
 FIS Profile FIRM Community Determined Other (Describe): FIELD SURVEY & INTERPOLATION FROM NGVD 29-B.M.S

B11. Indicate the elevation datum used for the BFE in B9: NGVD 1929 NAVD 1988 Other (Describe): _____

B12. Is the building located in a Coastal Barrier Resources System (CBRS) area or Otherwise Protected Area (OPA)? Yes No
 Designation Date: _____

SECTION C - BUILDING ELEVATION INFORMATION (SURVEY REQUIRED)

C1. Building elevations are based on: Construction Drawings* Building Under Construction* Finished Construction
 *A new Elevation Certificate will be required when construction of the building is complete.

2. Building Diagram Number 1 (Select the building diagram most similar to the building for which this certificate is being completed - see pages 6 and 7. If no diagram accurately represents the building, provide a sketch or photograph.)

C3. Elevations - Zones A1-A30, AE, AH, A (with BFE), VE, V1-V30, V (with BFE), AR, AR/A, AR/AE, AR/A1-A30, AR/AH, AR/AO
 Complete Items C3a-i below according to the building diagram specified in Item C2. State the datum used. If the datum is different from the datum used for the BFE in Section B, convert the datum to that used for the BFE. Show field measurements and datum conversion calculation. Use the space provided or the Comments area of Section D or Section G, as appropriate, to document the datum conversion.
 Datum NGVD 1929 Conversion/Comments _____

Elevation reference mark used _____ Does the elevation reference mark used appear on the FIRM? Yes No

a) Top of bottom floor (including basement or enclosure) _____ ft.(m) 80.6

b) Top of next higher floor _____ ft.(m)

c) Bottom of lowest horizontal structural member (V zones only) _____ ft.(m)

d) Attached garage (top of slab) _____ ft.(m)


e) Lowest elevation of machinery and/or equipment servicing the building _____ ft.(m)

f) Lowest adjacent grade (LAG) _____ ft.(m) 80.0

g) Highest adjacent grade (HAG) _____ ft.(m) 80.3

h) No. of permanent openings (flood vents) within 1 ft. above adjacent grade N/A

i) Total area of all permanent openings (flood vents) in C3h N/A sq. in. (sq. cm)

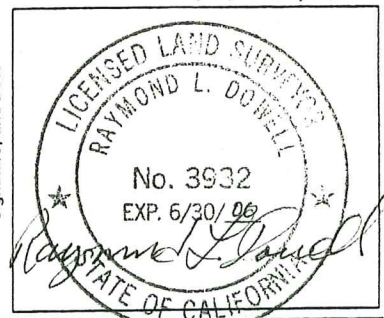

SECTION D - SURVEYOR, ENGINEER, OR ARCHITECT CERTIFICATION

This certification is to be signed and sealed by a land surveyor, engineer, or architect authorized by law to certify elevation information.
 I certify that the information in Sections A, B, and C on this certificate represents my best efforts to interpret the data available.
 I understand that any false statement may be punishable by fine or imprisonment under 18 U.S. Code, Section 1001.

CERTIFIER'S NAME RAYMOND L. DOWELL LICENSE NUMBER L.S. 3932

TITLE OWNER COMPANY NAME RAYMOND DOWELL - LAND SURVEYOR

ADDRESS 17873 CO. RD. 97 CITY WOODLAND STATE CA. ZIP CODE 95695

SIGNATURE Raymond L. Dowell DATE 5/10/00 TELEPHONE 530-662-0807

IMPORTANT: In these spaces, copy the corresponding information from Section A.			For Insurance Company Use:
BUILDING STREET ADDRESS (Including Apt., Unit, Suite, and/or Bldg. No.) OR P.O. ROUTE AND BOX NO. 35956 ACADIA LN.			Policy Number
CITY DAVIS	STATE CA	ZIP CODE 95616	Company NAIC Number

SECTION D - SURVEYOR, ENGINEER, OR ARCHITECT CERTIFICATION (CONTINUED)

Copy both sides of this Elevation Certificate for (1) community official, (2) insurance agent/company, and (3) building owner.

COMMENTS SEE ATTACHED EXHIBIT "A" AND EXHIBIT "B" FOR ELEVATION AND SITE LOCATION DETAIL

Check here if attachments

SECTION E - BUILDING ELEVATION INFORMATION (SURVEY NOT REQUIRED) FOR ZONE AO and ZONE A (WITHOUT BFE)

For Zone AO and Zone A (without BFE), complete Items E1 through E3. If the Elevation Certificate is intended for use as supporting information for a LOMA or LOMR-F, Section C must be completed.

- E1. Building Diagram Number (Select the building diagram most similar to the building for which this certificate is being completed - see pages 6 and 7. If no diagram accurately represents the building, provide a sketch or photograph.)
- E2. The top of the bottom floor (including basement or enclosure) of the building is 0 ft.(m) 4 in.(cm) above or below (check one) the highest adjacent grade.
- E3. For Zone AO only: If no flood depth number is available, is the top of the bottom floor elevated in accordance with the community's floodplain management ordinance? Yes No Unknown. The local official must certify this information in Section G.

SECTION F - PROPERTY OWNER (OR OWNER'S REPRESENTATIVE) CERTIFICATION

The property owner or owner's authorized representative who completes Sections A, B, and E for Zone A (without a FEMA-issued or community-issued BFE) or Zone AO must sign here.

PROPERTY OWNER'S OR OWNER'S AUTHORIZED REPRESENTATIVE'S NAME RAYMOND L. DOWELL

ADDRESS 17873 CO. RD. 97 CITY WOODLAND STATE CA ZIP CODE 95695

SIGNATURE Raymond L. Dowell DATE 6/10/00 TELEPHONE 530-662-0807

COMMENTS

Check here if attachments

SECTION G - COMMUNITY INFORMATION (OPTIONAL)

The local official who is authorized by law or ordinance to administer the community's floodplain management ordinance can complete Sections A, B, C (or E), and G of this Elevation Certificate. Complete the applicable item(s) and sign below.



- G1. The information in Section C was taken from other documentation that has been signed and embossed by a licensed surveyor, engineer, or architect who is authorized by state or local law to certify elevation information. (Indicate the source and date of the elevation data in the Comments area below.)
- G2. A community official completed Section E for a building located in Zone A (without a FEMA-issued or community-issued BFE) or Zone AO.
- G3. The following information (Items G4-G9) is provided for community floodplain management purposes.

G4. PERMIT NUMBER	G5. DATE PERMIT ISSUED	G6. DATE CERTIFICATE OF COMPLIANCE/OCCUPANCY ISSUED
-------------------	------------------------	-----------------------------------------------------

- G7. This permit has been issued for: New Construction Substantial Improvement
- G8. Elevation of as-built lowest floor (including basement) of the building is: _____ ft.(m) Datum: _____
- G9. BFE or (in Zone AO) depth of flooding at the building site is: _____ ft.(m) Datum: _____

LOCAL OFFICIAL'S NAME	TITLE
COMMUNITY NAME	TELEPHONE
SIGNATURE	DATE
COMMENTS	

Check here if attachments

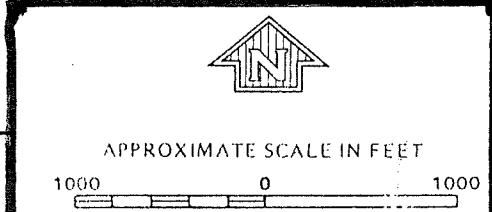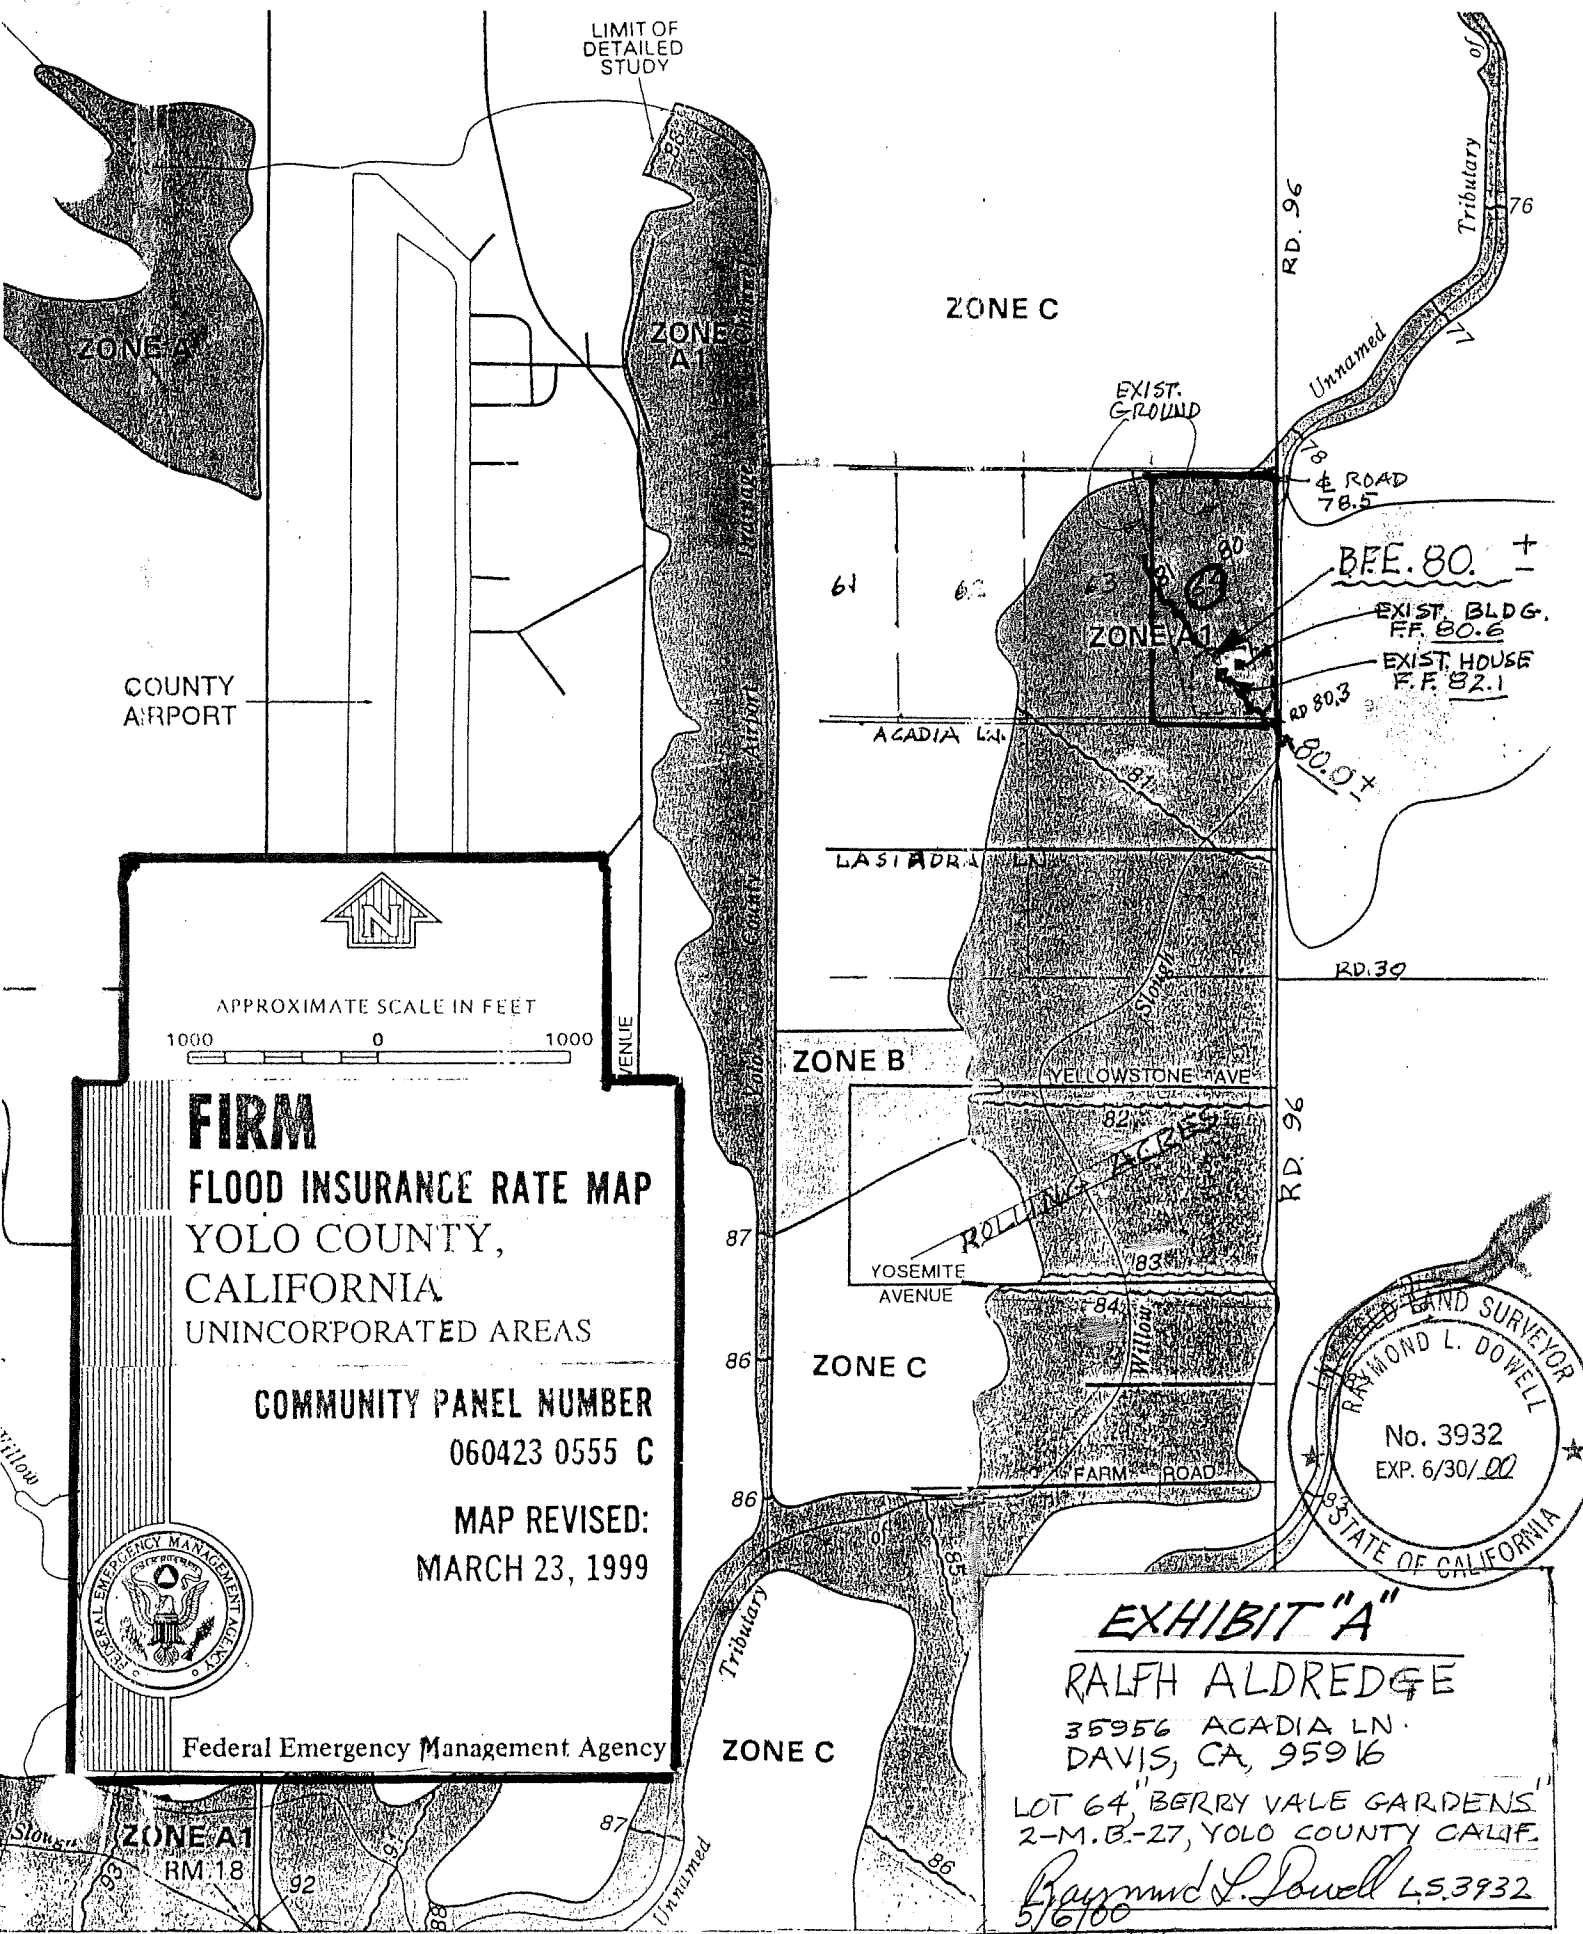

FIRM
FLOOD INSURANCE RATE MAP
YOLO COUNTY,
CALIFORNIA
UNINCORPORATED AREAS

COMMUNITY PANEL NUMBER
 060423 0555 C

MAP REVISED:
 MARCH 23, 1999

Federal Emergency Management Agency


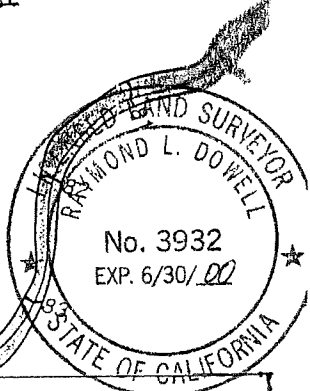


EXHIBIT "A"
RALPH ALDREDGE
 35956 ACADIA LN.
 DAVIS, CA, 95916
 LOT 64, "BERRY VALE GARDENS"
 2-M.B.-27, YOLO COUNTY CALIF.
 Raymond L. Dowell L.S. 3932
 5/6/00

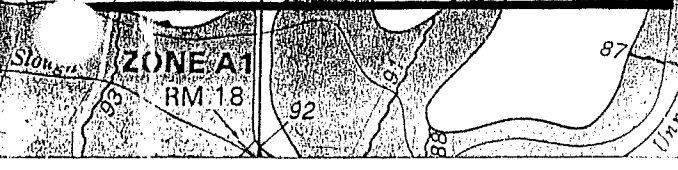

JOB: RALPH ALDREDGE
35956 ACADIA LN.
DAVIS, CA. 95616

RAYMOND L. DOWELL
17877 C. Rd. 97

PHONE

662-0807

LAND SURVEYOR
WOODLAND CA 95695

CHECKED BY

DATE

5/5/00


SCALE

1" = 200'

CALC BY

SH.

OF

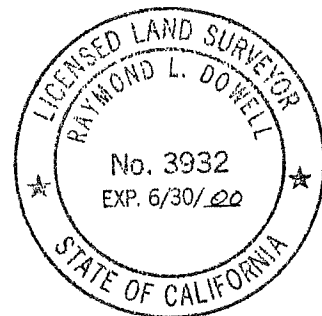

Raymond L. Dowell L.S. 3932
5/8/00

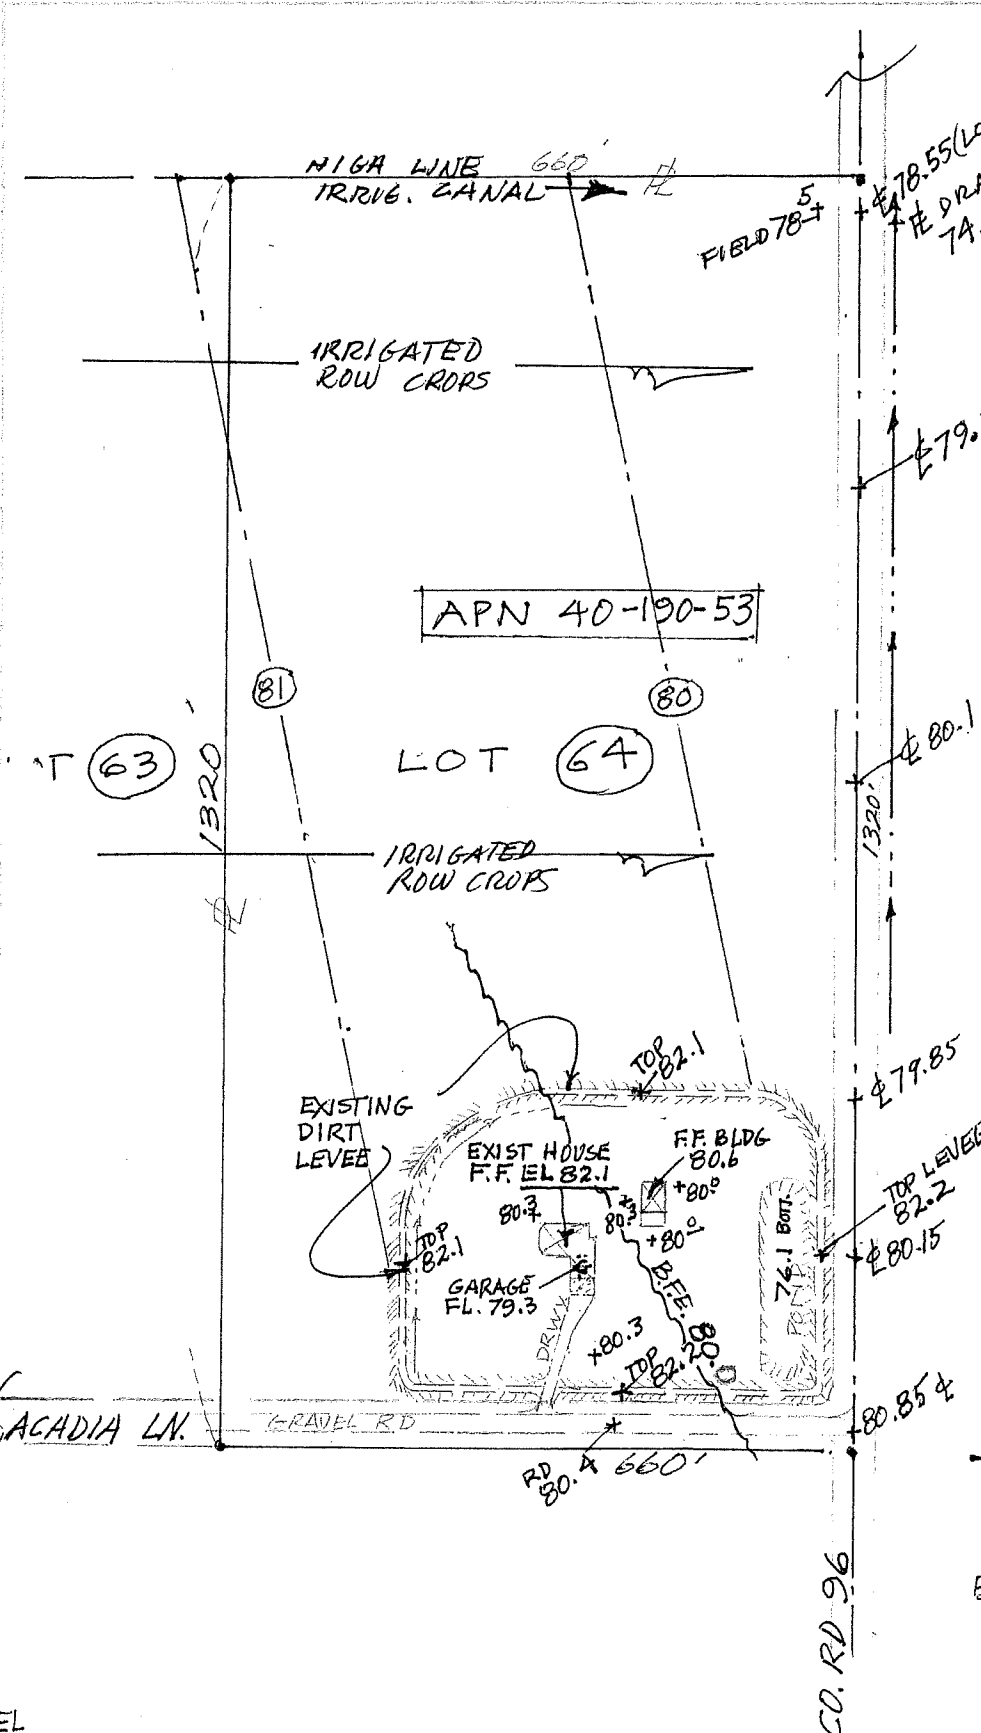


EXHIBIT "B"

APN. 40-190-53
LOT 64

BERRY VALE GARDENS
2-M.B.-27

EL (81) B.F.E. PER 060423-0555-C

