

FEDERAL EMERGENCY MANAGEMENT AGENCY
NATIONAL FLOOD INSURANCE PROGRAM

O.M.B. No. 3067-0077
Expires December 31, 2005

ELEVATION CERTIFICATE

Important: Read the instructions on pages 1 - 7.

206-0078

SECTION A - PROPERTY OWNER INFORMATION


BUILDING OWNER'S NAME: JOSE RAMIREZ
 BUILDING STREET ADDRESS (Including Apt., Unit, Suite, and/or Bldg. No.) OR P.O. ROUTE AND BOX NO.: 29029 MAIN ST.
 CITY: MADISON STATE: CA ZIP CODE: 95653
 PROPERTY DESCRIPTION (Lot and Block Numbers, Tax Parcel Number, Legal Description, etc.): 049-45703
 BUILDING USE (e.g., Residential, Non-residential, Addition, Accessory, etc. Use a Comments area, if necessary.): LOT 12 AND 13, BLK. 15, TOWN OF MADISON
 LATITUDE/LONGITUDE (OPTIONAL) (##° - ##' - ##.###" or ##.#####") HORIZONTAL DATUM: SOURCE: GPS (Type): USGS Quad Map Other

SECTION B - FLOOD INSURANCE RATE MAP (FIRM) INFORMATION

B1. NFIP COMMUNITY NAME & COMMUNITY NUMBER: 0604230387 B2. COUNTY NAME: YOLO B3. STATE: CA
 B4. MAP AND PANEL NUMBER: 0604230387 B5. SUFFIX: C B6. FIRM INDEX DATE: MAR 23 1999 B7. FIRM PANEL EFFECTIVE/REVISED DATE: B8. FLOOD ZONE(S): AO B9. BASE FLOOD ELEVATION(S) (Zone AO, use depth of flooding): 1.0 FT.
 B10. Indicate the source of the Base Flood Elevation (BFE) data or base flood depth entered in B9.
 FIS Profile FIRM Community Determined Other (Describe): PER EXIST. GROUND ELEVATION
 B11. Indicate the elevation datum used for the BFE in B9: NGVD 1929 NAVD 1988 Other (Describe):
 B12. Is the building located in a Coastal Barrier Resources System (CBRS) area or Otherwise Protected Area (OPA)? Yes No
 Designation Date:

SECTION C - BUILDING ELEVATION INFORMATION (SURVEY REQUIRED)

C1. Building elevations are based on: Construction Drawings* Building Under Construction* Finished Construction
 *A new Elevation Certificate will be required when construction of the building is complete.
 C2. Building Diagram Number: 8 (Select the building diagram most similar to the building for which this certificate is being completed - see pages 6 and 7. If no diagram accurately represents the building, provide a sketch or photograph.)
 C3. Elevations - Zones A1-A30, AE, AH, A (with BFE), VE, V1-V30, V (with BFE), AR, ARA, AR/AE, AR/A1-A30, AR/AH, AR/AO
 Complete Items C3.a-i below according to the building diagram specified in Item C2. State the datum used. If the datum is different from the datum used for the BFE in Section B, convert the datum to that used for the BFE. Show field measurements and datum conversion calculation. Use the space provided or the Comments area of Section D or Section G, as appropriate, to document the datum conversion.
 Datum: NGVD 1929 Conversion/Comments:
 Elevation reference mark used: B-38 RESET (USGS) Does the elevation reference mark used appear on the FIRM? Yes No
 a) Top of bottom floor (including basement or enclosure) 153.0 ft(m)
 b) Top of next higher floor _____ ft(m)
 c) Bottom of lowest horizontal structural member (V zones only) _____ ft(m)
 d) Attached garage (top of slab) 151.0 ft(m)
 e) Lowest elevation of machinery and/or equipment servicing the building (Describe in a Comments area.) 153.3 ft(m)
 f) Lowest adjacent (finished) grade (LAG) 149.3 ft(m)
 g) Highest adjacent (finished) grade (HAG) 150.3 ft(m)
 h) No. of permanent openings (flood vents) within 1 ft. above adjacent grade: 26
 i) Total area of all permanent openings (flood vents) in C3.h: 2340 sq. in. (sq. cm)

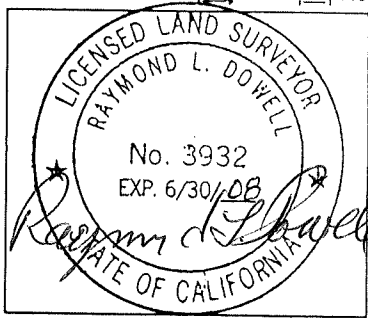

SECTION D - SURVEYOR, ENGINEER, OR ARCHITECT CERTIFICATION

This certification is to be signed and sealed by a land surveyor, engineer, or architect authorized by law to certify elevation information.
 I certify that the information in Sections A, B, and C on this certificate represents my best efforts to interpret the data available.
 I understand that any false statement may be punishable by fine or imprisonment under 18 U.S. Code, Section 1001.
 CERTIFIER'S NAME: RAYMOND L. DOWELL LICENSE NUMBER: L.S. 3932
 TITLE: OWNER COMPANY NAME: RAYMOND DOWELL LAND SURVEYOR
 ADDRESS: 17873 CO. RD 97 WOODLAND CITY: CA STATE: CA ZIP CODE: 95695
 SIGNATURE: Raymond L. Dowell DATE: 2/15/08 TELEPHONE: 530-662-0807

IMPORTANT: In these spaces, copy the corresponding information from Section A.			For Insurance Company Use:	
BUILDING STREET ADDRESS (Including Apt., Unit, Suite, and/or Bldg. No.) OR P.O. ROUTE AND BOX NO. 29029 MAIN ST.			Policy Number	
CITY MADISON	STATE CA.	ZIP CODE 95653	Company NAIC Number	

SECTION D - SURVEYOR, ENGINEER, OR ARCHITECT CERTIFICATION (CONTINUED)

Copy both sides of this Elevation Certificate for (1) community official, (2) insurance agent/company, and (3) building owner.

COMMENTS BUILDING INFO DERIVED FROM CONSTRUCTION PLANS BY ARCHITECT, AND FIELD CHECKED FOR AS BUILT

Check here if attachments

SECTION E - BUILDING ELEVATION INFORMATION (SURVEY NOT REQUIRED) FOR ZONE AO AND ZONE A (WITHOUT BFE)

For Zone AO and Zone A (without BFE), complete Items E1. through E5. If the Elevation Certificate is intended for use as supporting information for a LOMA or LOMR-F, Section C must be completed.

- E1. Building Diagram Number ____ (Select the building diagram most similar to the building for which this certificate is being completed - see pages 6 and 7. If no diagram accurately represents the building, provide a sketch or photograph.)
- E2. The top of the bottom floor (including basement or enclosure) of the building is ____ ft. (m) ____ in. (cm) ____ above or ____ below (check one) the highest adjacent grade. (Use natural grade, if available.)
- E3. For Building Diagrams 6-8 with openings (see page 7), the next higher floor or elevated floor (elevation b) of the building is ____ ft. (m) ____ in. (cm) above the highest adjacent grade. Complete Items C3.h and C3.i on front of form.
- E4. The top of the platform of machinery and/or equipment servicing the building is ____ ft. (m) ____ in. (cm) ____ above or ____ below (check one) the highest adjacent grade. (Use natural grade, if available.)
- E5. For Zone AO only: If no flood depth number is available, is the top of the bottom floor elevated in accordance with the community's floodplain management ordinance? Yes No Unknown. The local official must certify this information in Section G.

SECTION F - PROPERTY OWNER (OR OWNER'S REPRESENTATIVE) CERTIFICATION

The property owner or owner's authorized representative who completes Sections A, B, C (Items C3.h and C3.i only), and E for Zone A (without a FEMA-issued or community-issued BFE) or Zone AO must sign here. *The statements in Sections A, B, C, and E are correct to the best of my knowledge.*

PROPERTY OWNER'S OR OWNER'S AUTHORIZED REPRESENTATIVE'S NAME RAYMOND L. DOWELL - L.S. 3932				
ADDRESS 17873 CO. RD. 97		CITY WOODLAND	STATE CA.	ZIP CODE 95695
SIGNATURE <i>Raymond L. Dowell</i>		DATE 2/15/08	TELEPHONE 530-662-0807	
COMMENTS				

Check here if attachments

SECTION G - COMMUNITY INFORMATION (OPTIONAL)

The local official who is authorized by law or ordinance to administer the community's floodplain management ordinance can complete Sections A, B, C (or E), and G of this Elevation Certificate. Complete the applicable item(s) and sign below.

- G1. The information in Section C was taken from other documentation that has been signed and embossed by a licensed surveyor, engineer, or architect who is authorized by state or local law to certify elevation information. (Indicate the source and date of the elevation data in the Comments area below.)
- G2. A community official completed Section E for a building located in Zone A (without a FEMA-issued or community-issued BFE) or Zone AO.
- G3. The following information (Items G4-G9) is provided for community floodplain management purposes.

G4. PERMIT NUMBER 200-0678	G5. DATE PERMIT ISSUED 8-11-06	G6. DATE CERTIFICATE OF COMPLIANCE/OCCUPANCY ISSUED 5-2-08
-------------------------------	-----------------------------------	---

- G7. This permit has been issued for: New Construction Substantial Improvement
- G8. Elevation of as-built lowest floor (including basement) of the building is: _____ ft. (m) Datum: _____
- G9. BFE or (in Zone AO) depth of flooding at the building site is: _____ ft. (m) Datum: _____


LOCAL OFFICIAL'S NAME Sergio Caldera	TITLE Assistant Building official
COMMUNITY NAME Yolo County	TELEPHONE (530) 666-8805
SIGNATURE <i>Sergio Caldera</i>	DATE 5-2-08
COMMENTS	

Check here if attachments

ZONE AO



APPROXIMATE SCALE IN FEET

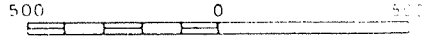

NATIONAL FLOOD INSURANCE PROGRAM

FIRM FLOOD INSURANCE RATE MAP

YOLO COUNTY,
CALIFORNIA
UNINCORPORATED AREAS

PANEL 387 OF 725

(SEE MAP INDEX FOR PANELS NOT PRINTED)

COMMUNITY PANEL NUMBER

060423 0387 C

MAP REVISED

MARCH 23, 1999



Federal Emergency Management Agency

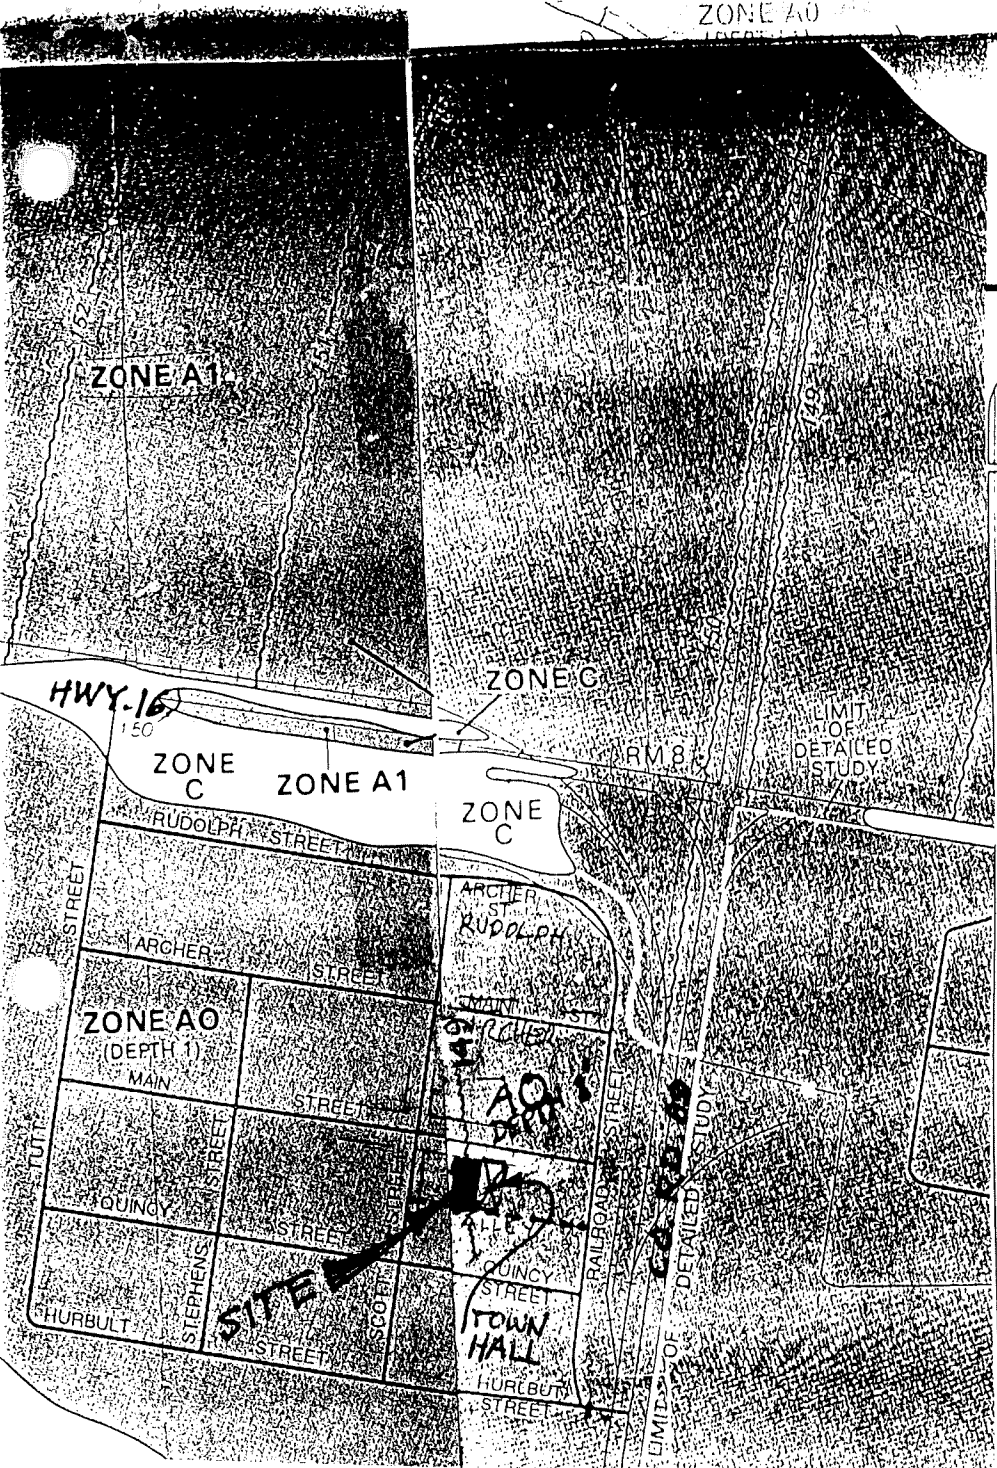


EXHIBIT "A"
JOSE RAMIREZ
LOTS 12 & 13, BLOCK 15, MADISON
YOLO COUNTY, CALIFORNIA

Raymond J. Dowd, L.S. 3932, 9/12/05
2/15/08

060423 0386-C
MAR 23, 1999

060423 0387-C
MAR 23, 1999

EXHIBIT "A"

JOSE RAMIREZ
 TOPO LOT 12, 13, BLK 15
 TOWN OF MADISON, YOLO CO. CALIF.

CHECKED BY

DATE 9/10/03 12/05/07
 REV. 2/15/08

SCALE 1" = 20' CALC BY

LAND SURVEYOR
 WOODLAND CA 95695

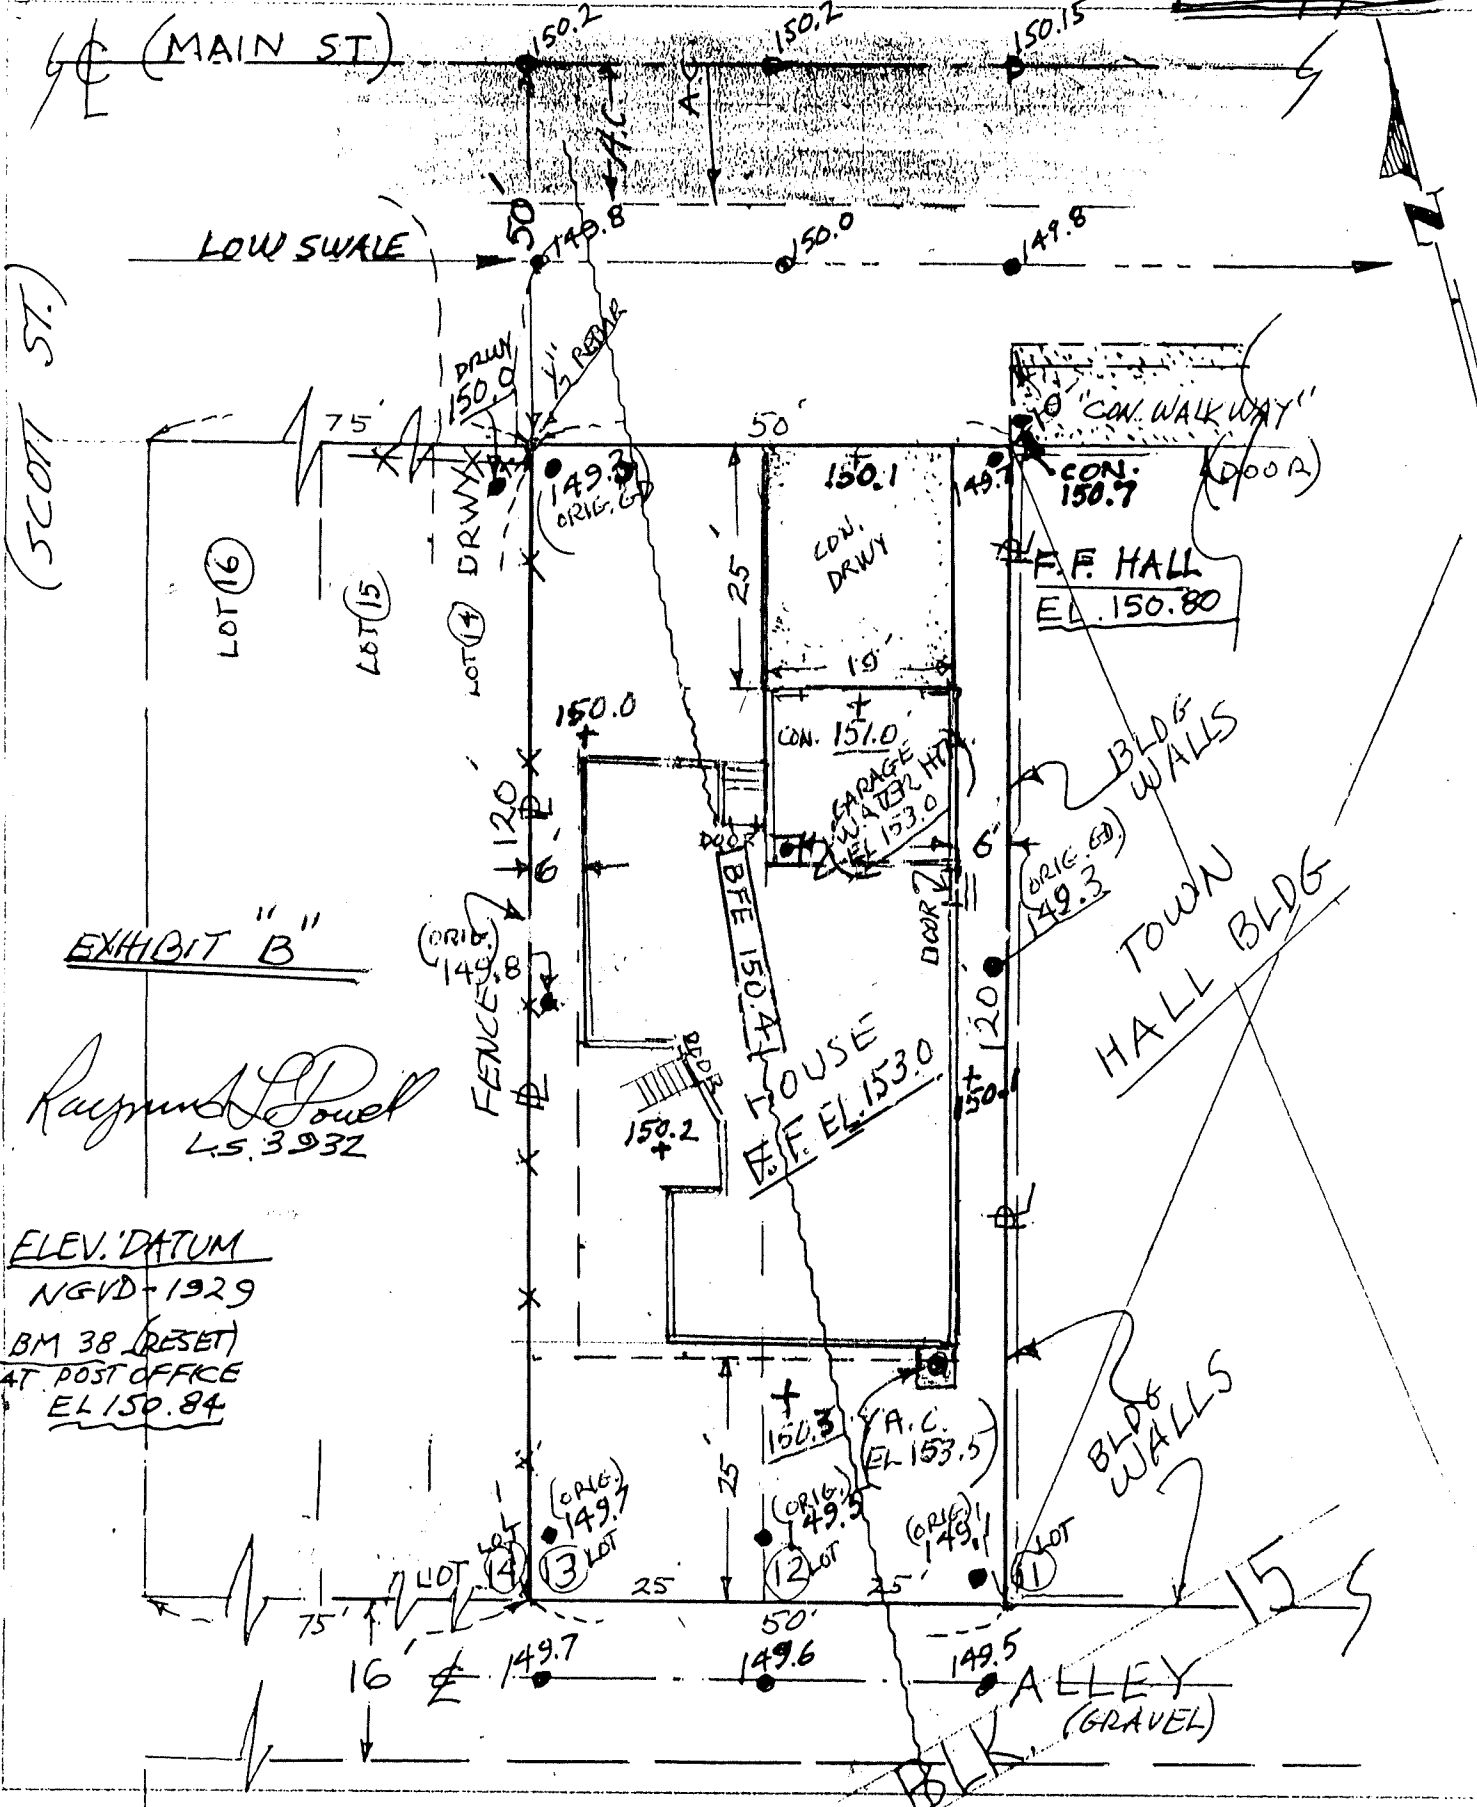


EXHIBIT "B"

Raymond Powell
 L.S. 3932

ELEV. DATUM
 NGVD-1929
 BM 38 (RESET)
 AT POST OFFICE
 EL 150.84

